

WARREN
F
2005

MISSISSIPPI
BOARD OF WATER COMMISSIONERS
416 North State Street
Jackson, Mississippi 39201

WATER WELL DRILLERS LOG

Nov. 10 1982 E.M. "Bud" Cresswell Warren
date well completed firm name county well located

LANDOWNER:	description of formations encountered	from	to
<u>Mrs. Mitchell Hunting Club</u> <u>Valley Park - Mo.</u> (mailing address)			
WELL LOCATION: sec <u>6</u> T <u>17</u> N R <u>4</u> E <u>2</u> miles <u>West</u> <u>Redwood</u> (distance) (direction) (nearest town)			
WELL PURPOSE: <u>Camp</u> (home, irrigation, municipal, industrial)			
WELL COMPLETION DATA: (1) diameter (inches) <u>4</u> (2) total depth (feet) <u>120</u> (3) static water level (feet) <u>12</u> below above top of ground. (4) casing <u>PVC</u> <u>100</u> (material) (depth) <u>4</u> if telescope see back. (size) (5) screen <u>20</u> <u>100</u> (length) (depth to top) <u>4</u> <u>PVC</u> (size) (material) (6) pump <u>1</u> <u>20</u> (HP) (yield gpm) (type power) (7) electric log <u>No</u> (yes or no) (organization running log) (8) How well bottom plugged <u>back wash valve</u>			

DRILLERS REMARKS:


DEPT. OF NATURAL RESOURCES
BUREAU OF LAND & WATER RESOURCES

NOV 22 1982

RECEIVED

If well telescopes please
sketch and show depths.

GROUND LEVEL

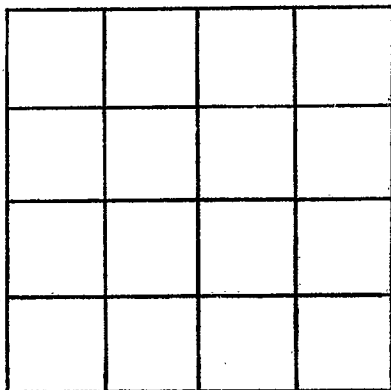

SECTION _____

Please indicate well location X.

ADDITIONAL INFORMATION

If more than one screen,
show locations of each on sketch.