

MISSISSIPPI DEPARTMENT OF NATURAL RESOURCES

Bureau of Land and Water Resources

Southport Mall

P.O. Box 10631

Jackson, Mississippi 39209

WATER WELL DRILLERS LOG

WARREN
F 2000

12-11
date well completed

1987 E.M. "Bud" Cresswell WARREN
firm name county well located

LANDOWNER:	description of formations encountered	from	to
C.C. Thrash			
Redwood, Ms. (mailing address)	Sand - gravel	50	170
WELL LOCATION:	Wagon Clay	170	670
sec. 4 T. 7 N. R. 4 E	Warden Bluff	670	700
1 miles West of Redwood (distance) (direction) (nearest town)	Thin Sand lignite	700	730
WELL PURPOSE: Home (home, irrigation, municipal, industrial)	Shale	730	740
WELL COMPLETION DATA:	Sand fine	740	780
(1) diameter (inches) 4	Sand, good -	780	820
(2) total depth (feet) 820			
(3) static water level (feet) 4 below top of ground.			
(4) casing Steel 880 (material) (depth)			
4 (size) if telescope see back.			
(5) screen 40 880 (length) (depth to top)			
2 STAINLESS (size) (material)			
(6) pump 1 20 (HP) (yield gpm)			
(type power)			
(7) electric log no (yes or no)			
(organization running log)			
(8) how well bottom plugged Sand & sh			
DRILLERS REMARKS:			
Water - straw colored			


REGISTERED

JAN 11 1988

Department of Natural Resources
Bureau of Land and Water Resources

If well telescopes please sketch and show depths.

GROUND LEVEL

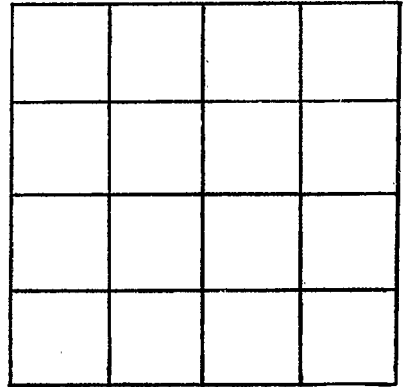

SECTION _____

Please indicate well location X.

ADDITIONAL INFORMATION

If more than one screen,
show locations of each on sketch.