

MISSISSIPPI DEPARTMENT OF NATURAL RESOURCES

Bureau of Land and Water Resources

Southport Mall

P.O. Box 10631

Jackson, Mississippi 39209

WATER WELL DRILLERS LOG

WARREN
F 2051

Oct. 7 1988 L.M. Red Crosswell WARREN
date well completed firm name county well located


LANDOWNER:	description of formations encountered	from	to
Twist Lakes Hunting Club Redwood, MS. (mailing address)			
WELL LOCATION: sec. 5 T 17 N R 4 E 2 miles West Redwood (distance) (direction) (nearest town)	Sand-gravel	30	100
WELL PURPOSE: Camp (home, irrigation, municipal, industrial)			
WELL COMPLETION DATA:			
(1) diameter (inches) 2			
(2) total depth (feet) 100			
(3) static water level (feet) 30 below top of ground.			
(4) casing PVC 90 (material) (depth)			
2 (size) if telescope see back.			
(5) screen 10 90 (length) (depth to top)			
2 PVC (size) (material)			
(6) pump 3/4 10 (HP) (yield gpm)			
(type power)			
(7) electric log no (yes or no)			
(organization running log)			
(8) how well bottom plugged Sand-shale			
DRILLERS REMARKS:			

RECEIVED
NOV 2 1988

Department of Natural Resources
Bureau of Land & Water Resources

If well telescopes please
sketch and show depths.

GROUND LEVEL

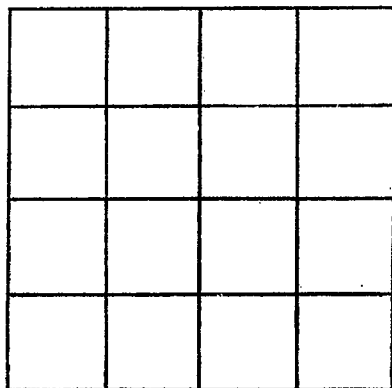

SECTION _____

Please indicate well location X.

ADDITIONAL INFORMATION

If more than one screen,
show locations of each on sketch.