

WARREN

G8

10-15-70

MISSISSIPPI
 BOARD OF WATER COMMISSIONERS
 416 North State Street
 Jackson, Mississippi 39201

CODED

WATER WELL DRILLERS LOG

Oct. 15 1970
date well completed

K. M. "Bud" Cresswell
firm name

WARREN
county well located

LANDOWNER:

WARREN THOMAS
Redwood, Miss-
(mailing address)

description of formations encountered

from to

Clay
Sandy-gravel 0 80
80 131

WELL LOCATION:

sec. 3 T. 7 N R. 5 E
1 miles North of Oak Ridge
(distance) (direction) (nearest town)

WELL PURPOSE: Domestic
(home, irrigation, municipal, industrial)

WELL COMPLETION DATA:

- (1) diameter (inches) 2
- (2) total depth (feet) 131
- (3) static water level (feet) 90 below top of ground.
- (4) casing Steel 126 (material) (depth)
2" (size) if telescope see back.
- (5) screen 5ft. 126 (length) (depth to top)
2" (size) Stainless (material)
- (6) pump 1 5 (HP) (yield gpm)
0 (type power)
- (7) electric log 0 (yes or no)
0 (organization running log)

CODED

(8) how well bottom plugged
Steel plug


DRILLERS REMARKS:

OCT 22 1970

MISS. BD. OF WATER COMM.

If well telescopes please sketch and show depths.

GROUND LEVEL

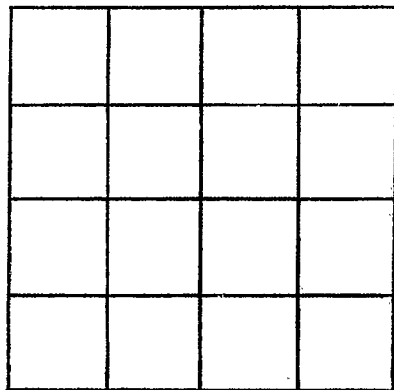

SECTION _____

Please indicate well location X.

ADDITIONAL INFORMATION

If more than one screen,
show locations of each on sketch.