

WARREN

MISSISSIPPI BOARD OF WATER COMMISSIONERS

G 10

2-27-63

WATER WELL DRILLERS LOG

CODED

Date: 2/27, 1963, Driller: C.P. Clark County Warren

(Name)

(1) Owner of Land:	Description & Color of Materials Sand, Clay, Red Clay, Shell, etc.	Thick- ness Feet	Depth Feet
James E. Hancock (Name) Rt #3 Wicksburg Miss (Address)	0-60 Brown Clay 60-117 Sand	60 57	
(2) Location: 1/4, 1/4, Sec. 17 17 R5,			
13 miles N.E. of Wicksburg (distance) (direction) (Nearest Town)			
(3) Topography: <input checked="" type="checkbox"/> (Hilly) <input type="checkbox"/> (Flat) <input type="checkbox"/> (Level)			
(4) Purpose of Well: Domestic (Domestic Irrigation Municipal, Industrial, Other)			

Information upon completion of well:


CODED

- (1) Diameter 2 inches.
- (2) Total Depth 117 feet.
- (3) Water Level 92 feet below top of ground.
- (4) Cased to 107, Size 2 in
- (5) Screen: Size 1 1/4, Length 10 ft
- (6) Were any formations sealed against pollution?
 yes, no.

If YES depth of formation _____

Why _____

Drillers Remarks: _____

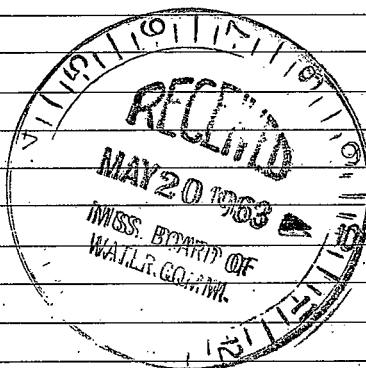

(Use Back Side)

Well No.

