

C. P. CLARK  
 WATER WELL DRILLING  
 ROUTE 2

LAUREL, MISS. 39440  
 MISSISSIPPI

BOARD OF WATER COMMISSIONERS  
 416 North State Street  
 Jackson, Mississippi 39201

**CODED**

WATER WELL DRILLERS LOG

Warren  
 G-11  
 6-68

6/19 1968 ~~J.H. Rushing~~ Warren  
 date well completed firm name county well located

LANDOWNER: J.H. Rushing  
 Rt # 3

| description of formations encountered | from | to  |
|---------------------------------------|------|-----|
| Brown clay                            | 0    | 55  |
| Yellow clay                           | 55   | 85  |
| Sand                                  | 85   | 116 |

Wicksburg Miss  
 (mailing address)

WELL LOCATION:  
 7 sec. T 14 N R 3 E S  
 15 miles NE of Wicksburg  
 (distance) (direction) (nearest town)

WELL PURPOSE:  
 (home, irrigation, municipal, industrial)

- WELL COMPLETION DATA:
- (1) diameter (inches) 2
  - (2) total depth (feet) 116
  - (3) static water level (feet) 80 below above top of ground.
  - (4) casing Galvalume (material) (depth) (size) If telescope see back.
  - (5) screen 10 106 (length) (depth to top) 1 1/4 3.5 (size) (material)
  - (6) pump 1 8 (HP) (yield gpm) 220 Single P. (type power)
  - (7) electric log No (yes or no)
  - (8) how well bottom plugged BWV


**CODED**

APR 10 1968  
 MISS. BOARD  
 WATER COMMISSIONERS

DRILLERS REMARKS: I do not have map to pinpoint but well located 1 mile south of oak ridge school

If well telescopes please sketch and show depths.

GROUND LEVEL

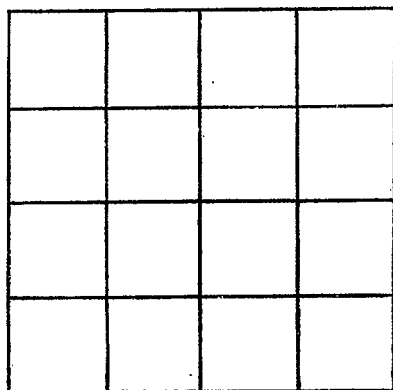

SECTION \_\_\_\_\_

Please indicate well location X.

ADDITIONAL INFORMATION

If more than one screen, show locations of each on sketch.