

WARREN  
G13  
5-2-72

MISSISSIPPI  
BOARD OF WATER COMMISSIONERS  
416 North State Street  
Jackson, Mississippi 39201

**CODED**

WATER WELL DRILLERS LOG

MAY 2 1972 R.A. "Bud" Besswell WARREN  
date well completed firm name county well located

LANDOWNER:	description of formations encountered	from	to
Margaret H. Pettis Vicksburg, Miss. (mailing address)			
WELL LOCATION:			
sec. 2 <sup>6</sup> T 17 <sup>N</sup> R 5 <sup>E</sup> 7 miles E of Redwood (distance) (direction) (nearest town)			
WELL PURPOSE: Domestic (home, irrigation, municipal, industrial)			
WELL COMPLETION DATA:			
(1) diameter (inches) 2			
(2) total depth (feet) 85			
(3) static water level (feet) 65 below top of ground.			
(4) casing Steel 80 (material) (depth) 2 (size) if telescope see back.			
(5) screen 5 80 (length) (depth to top) 2, Stainless (size) (material)			
(6) pump 1 5 (HP) (yield gpm) 0 (type power)			
(7) electric log No (yes or no) 0 (organization running log)			
(8) how well bottom plugged Steel plug			
DRILLERS REMARKS:			


**CODED**

MAY 25 1972

MISS. Bd. OF  
WATER COM.

If well telescopes please sketch and show depths.

GROUND LEVEL

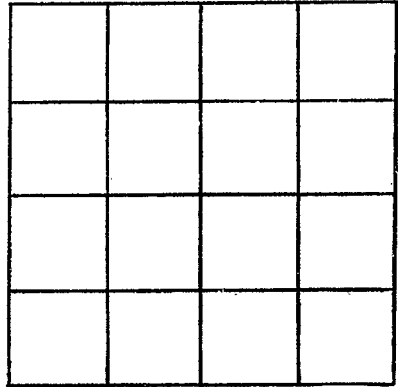

SECTION \_\_\_\_\_

Please indicate well location X.

ADDITIONAL INFORMATION

If more than one screen, show locations of each on sketch.