

WARREN
G 14
6-72

MISSISSIPPI
BOARD OF WATER COMMISSIONERS
416 North State Street
Jackson, Mississippi 39201

WATER WELL DRILLERS LOG

June 1972 E B Jon Warren
date well completed firm name county well located

LANDOWNER: Robert Reddie
Oak Ridge Vickburg, Miss.
(mailing address)

description of formations encountered	from	to
Brown silice	0	81
Packed sand	81	90
White cl	90	102
Sand	102	124

WELL LOCATION:
sec. 3 T 17 N R 5 E
15 miles NW of Pickensburg
(distance) (direction) (nearest town)

WELL PURPOSE:
(home, irrigation, municipal, industrial)


- WELL COMPLETION DATA:
- (1) diameter (inches) 4 1/4
 - (2) total depth (feet) 124
 - (3) static water level (feet) 96 below top of ground.
 - (4) casing Galv 119 (material) (depth)
 - (size) if telescope see back.
 - (5) screen 6' 119 (length) (depth to top)
 - 2-08 SS (size) (material)
 - (6) pump 1 4 (HP) (yield gpm)
 - E/ee (type power)
 - (7) electric log No (yes or no)
 - None (organization running log)
 - (8) how well bottom plugged BWU

DRILLERS REMARKS:

JUL 17 1972

If well telescopes please sketch and show depths.

GROUND LEVEL

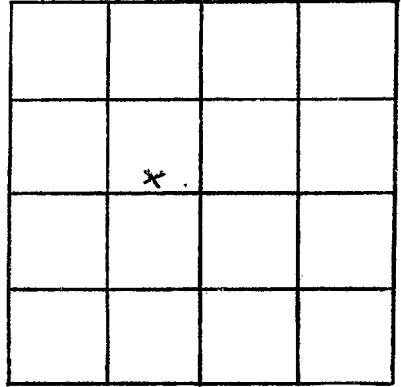

SECTION 3

Please indicate well location X.

ADDITIONAL INFORMATION

If more than one screen,
show locations of each on sketch.