

WARREN
G 15
1-22-74

MISSISSIPPI
 BOARD OF WATER COMMISSIONERS
 416 North State Street
 Jackson, Mississippi 39201

CODED

WATER WELL DRILLERS LOG

JAN. 22 1974 of K.M. "Bud" CRESSWELL WARREN
 date well completed firm name county well located

LANDOWNER:
JAMES O'CONNOR
Redwood, Miss.
 (mailing address)

description of formations encountered	from	to
<u>CLAY</u>	<u>0</u>	<u>85</u>
<u>SAND GRAVEL</u>	<u>85</u>	<u>131</u>

WELL LOCATION:
 sec. 2 T. 17 N. R. 5
6 miles EAST of Redwood
 (distance) (direction) (nearest town)

WELL PURPOSE: Home
 (home, irrigation, municipal, industrial)

- WELL COMPLETION DATA:**
- (1) diameter (inches) 2
 - (2) total depth (feet) 131
 - (3) static water level (feet) 80 below top of ground.
 - (4) casing Steel, 126
 (material) (depth)
2 if telescope see back.
 (size)
 - (5) screen 5, 126
 (length) (depth to top)
2, Stainless
 (size) (material)
 - (6) pump 1, 5
 (HP) (yield gpm)
0
 (type power)
 - (7) electric log No
 (yes or no)
0
 (organization running log)
 - (8) how well bottom plugged
Steel plug


CODED

DRILLERS REMARKS:

JAN 28 1974

If well telescopes please sketch and show depths.

GROUND LEVEL

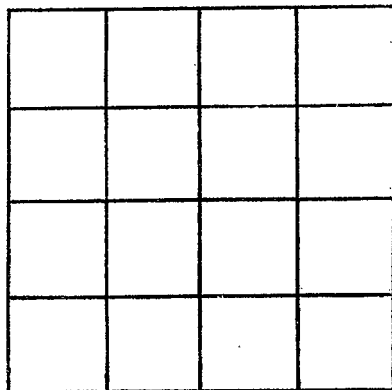

SECTION _____

Please indicate well location X.

ADDITIONAL INFORMATION

If more than one screen, show locations of each on sketch.