

**WARREN**  
**G 16**  
**12-26-73**

MISSISSIPPI  
 BOARD OF WATER COMMISSIONERS **CODED**  
 416 North State Street  
 Jackson, Mississippi 39201

**WATER WELL DRILLERS LOG**

Dec. 26 1973 B. E. M. "Bud" CRESSWELL WARREN  
 date well completed firm name county well located

**LANDOWNER:**

WARREN COUNTY FORESTRY TOWER  
Vicksburg, Miss.  
 (mailing address)

**description of formations encountered**

from to

<u>CLAY</u>	<u>0</u>	<u>80</u>
<u>SAND - GRAVEL</u>	<u>80</u>	<u>130</u>

**WELL LOCATION:**

sec. 18 T. 17 N R. 5 W  
5 miles EAST of Redwood  
 (distance) (direction) (nearest town)

**WELL PURPOSE:** Home  
 (home, irrigation, municipal, industrial)

**WELL COMPLETION DATA:**


- (1) diameter (inches) 2
- (2) total depth (feet) 130
- (3) static water level (feet) 90 below top of ground.
- (4) casing Steel, 120  
 (material) (depth)
- 2 if telescope see back.  
 (size)
- (5) screen 10, 120  
 (length) (depth to top)
- 2 STAINLESS  
 (size) (material)
- (6) pump 1 1/2, 8  
 (HP) (yield gpm)
- 0  
 (type power)
- (7) electric log no  
 (yes or no)
- 0  
 (organization running log)

**CODED**

(8) how well bottom plugged

Steel plug

**DRILLERS REMARKS:**

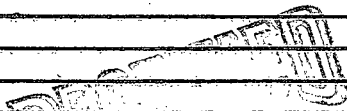


JAN 28 1974

MISSISSIPPI  
 BOARD OF WATER COMMISSIONERS

If well telescopes please sketch and show depths.

GROUND LEVEL

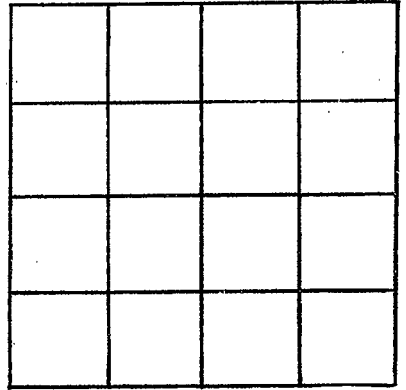

SECTION \_\_\_\_\_

Please indicate well location X.

ADDITIONAL INFORMATION

If more than one screen,  
show locations of each on sketch.