

WARREN
517
6/6/80

MISSISSIPPI
BOARD OF WATER COMMISSIONERS
416 North State Street
Jackson, Mississippi 39201

CODED

WATER WELL DRILLERS LOG

6-6-80 *Grimes Drilling Warren*
date well completed firm name county well located

LANDOWNER:
Union Oil of California
325 Cottage Hill Rd
Mobile, Ala
(mailing address)
WELL LOCATION: *2329N F2490E*
sec. *29* T-*17*S R-*5*W of *Super*
Redwood
(distance) (direction) (nearest town)

Description of formations encountered	from	to
<i>clay</i>	<i>0</i>	<i>63</i>
<i>clay + rocks</i>	<i>63</i>	<i>189</i>
<i>streaked sand</i>	<i>189</i>	<i>315</i>
<i>shell</i>		
<i>chalk</i>	<i>315</i>	<i>483</i>
<i>sand + shell</i>	<i>483</i>	<i>525</i>
<i>chalk</i>	<i>525</i>	<i>830</i>
<i>sand + shell</i>	<i>830</i>	<i>893</i>
<i>sand</i>	<i>893</i>	<i>1176</i>

WELL PURPOSE: *oil field*
(home, irrigation, municipal, industrial)

WELL COMPLETION DATA:
(1) diameter (inches) *3"*
(2) total depth (feet) *1196'*
(3) static water level (feet) *185'* ^{below} top of ground.
(4) casing *steel* *1155'*
(material) (depth)
3" if telescope see back.
(size)
(5) screen *42'* *1113'*
(length) (depth to top)
3" *perforated*
(size) (material)
(6) pump *70*
(HP) (yield gpm)
AC
(type power)
(7) electric log _____
(yes or no)
(organization running log)

(8) how well bottom plugged *orange*
peel

DRILLERS REMARKS:

CODED


DEPT. OF NATURAL RESOURCES
BUREAU OF LAND & WATER RESOURCES

JUN 19 1980

RECEIVED

If well telescopes please sketch and show depths.

GROUND LEVEL

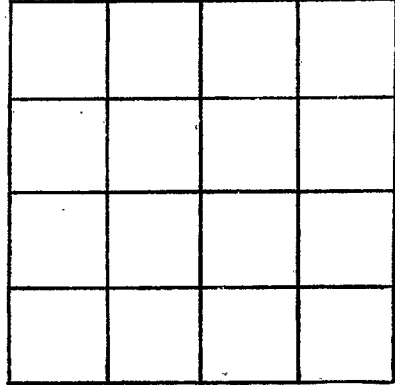

SECTION _____

Please indicate well location X.

ADDITIONAL INFORMATION

If more than one screen, show locations of each on sketch.