

WARREN

G-18

10/30/80

MISSISSIPPI BOARD OF WATER COMMISSIONERS  
416 North State Street  
Jackson, Mississippi 39201

CODED

WATER WELL DRILLERS LOG

10-30-80

Griner Drilling Service, Inc

Warren

date well completed

firm name

county well located

LANDOWNER:

Union Oil of California  
3100 Cottage Hill Rd.  
Suite 325  
Mobile, Ala 36616

description of formations encountered

from

to

clay rock	0	861
clay rock, sand shell	861	1022
sand	1022	1075
clay	1075	1094
sand	1094	1113
clay	1113	1169

WELL LOCATION:

no. 1 J.S. Terry  
sec. 17 T. 17 N. R. 5 E. 17-10  
Jerry Redwood  
of (distance) (direction) (nearest town)

WELL PURPOSE:

oil field supply  
(home, irrigation, municipal, industrial)

WELL COMPLETION DATA:

- (1) diameter (inches) 3"
- (2) total depth (feet) 1169'
- (3) static water level (feet) 150' below top of ground.
- (4) casing steel, 1169' (material) (depth)  
3" (size) If telescope see back.
- (5) screen 63' length, 1106' depth to top  
3" perforated (size) (material)
- (6) pump 70 (HP) (yield gpm)  
AC (type power)
- (7) electric log (yes or no)
- (8) how well bottom plugged orange

ATTN # 1350 W  
of DE CAR.

DEPT. OF NATURAL RESOURCES  
BUREAU OF LAND & WATER RESOURCES

NOV 25 1980


RECEIVED

DRILLERS REMARKS:

peel

If well telescopes please sketch and show depths.

GROUND LEVEL

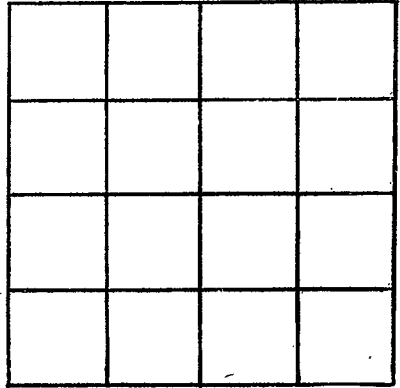

SECTION \_\_\_\_\_

Please indicate well location X.

ADDITIONAL INFORMATION

If more than one screen,  
show locations of each on sketch.