

MISSISSIPPI DEPARTMENT OF NATURAL RESOURCES

Bureau of Land and Water Resources

Southport Mall

P.O. Box 10631

Jackson, Mississippi 39209

WATER WELL DRILLERS LOG

CODED

WARREN
E 19
3/5/81

13-5 1981 Rayborn Drill. & Const. Co. Warren
date well completed firm name county well located

LANDOWNER:
Union Oil Co.
3100 College Rd
Suite 325
Mobile, Ala.
WELL LOCATION:
sec. 19 T-17N R-5E
S W
2 miles (distance) W of Vidalia, La. (direction) (nearest town)

description of formations encountered	from	to
Top Soil	0	2
clay	2	35
Gravel	35	300
Lime Rock	200	230
Shale	230	990
Shale & Sand	990	1010
Shale	1010	1160
Sand	1160	1213

WELL PURPOSE: Hydr.
(home, irrigation, municipal, industrial)


WELL COMPLETION DATA:
(1) diameter (inches) 3"
(2) total depth (feet) 1213'
(3) static water level (feet) 200' below top of ground.
(4) casing BHC 1213'
(material) (depth)
3" if telescope see back.
(size)
(5) screen 20'
(length) (depth to top)
(size) (material)
(6) pump 75 GPM
(HP) (yield gpm)
(type power)
(7) electric log no
(yes or no)
(organization running log)
(8) how well bottom plugged Wood Plug

CODED
(1500' S + 2589' W of NE Cor of Sec. 19)

DRILLERS REMARKS:

If well telescopes please
sketch and show depths.

GROUND LEVEL

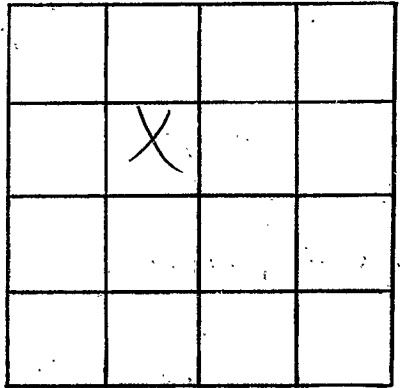

SECTION 19

Please indicate well location X.

ADDITIONAL INFORMATION

If more than one screen,
show locations of each on sketch.