

MISSISSIPPI DEPARTMENT OF NATURAL RESOURCES
Bureau of Land and Water Resources

Southport Mall
P.O. Box 10631

Jackson, Mississippi 39209

CODED

WATER WELL DRILLERS LOG

Warren
520
9-10-81

9-10-81 *Griner Drilling Service, Inc.* Warren

date well completed

firm name

county well located

LANDOWNER:

Union Oil of California
300 Cottage Hill Rd
Suite 325
Mobile, Ala 36616

description of formations encountered

from

to

<i>Top soil</i>	<i>0</i>	<i>3</i>
<i>CLAY</i>	<i>3</i>	<i>20</i>
<i>SAND</i>	<i>20</i>	<i>42</i>
<i>SAND + CLAY STREAKS</i>	<i>42</i>	<i>265</i>
<i>SAND</i>	<i>265</i>	<i>280</i>
<i>CLAY + SAND STREAKS</i>	<i>280</i>	<i>310</i>
<i>CLAY - HARD</i>	<i>310</i>	<i>810</i>
<i>SAND (thin) + CLAY STREAKS</i>	<i>810</i>	<i>1120</i>
<i>SAND</i>	<i>1120</i>	<i>1150</i>
<i>CLAY</i>	<i>1150</i>	<i>1245</i>
<i>SAND</i>	<i>1245</i>	<i>1365</i>

WELL LOCATION: *532' N + 575' W*

sec. *19* T. *17N* R. *5E* of *WSE/00*

No. 1 Fried's
Abraham Redwood

WELL PURPOSE: *oil field supply*
(home, irrigation, municipal, industrial)

WELL COMPLETION DATA:

- (1) diameter (inches) *3"*
- (2) total depth (feet) *1365'*
- (3) static water level (feet) *150'* *below* above top of ground.
- (4) casing *Steel*, *1365'*
(material) (depth)
- 3"*
(size) if telescope see back.
- (5) screen *63'*, *1302'*
(length) (depth to top)
- 3" perforated*
(size) (material)
- (6) pump *75-80*
(HP) (yield gpm)
- AC*
(type power)
- (7) electric log *—*
(yes or no)
- (organization running log)

CODED

DEPT. OF NATURAL RESOURCES
BUREAU OF LAND & WATER RESOURCES

OCT - 1 1981


RECEIVED

(8) how well bottom plugged *margin*
plugged

DRILLERS REMARKS:

If well telescopes please
sketch and show depths.

GROUND LEVEL

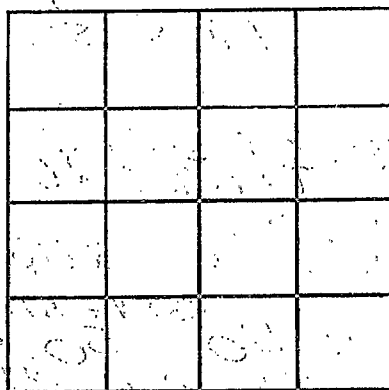

SECTION _____

Please indicate well location X.

ADDITIONAL INFORMATION

If more than one screen,
show locations of each on sketch.