

MISSISSIPPI DEPARTMENT OF NATURAL RESOURCES

Bureau of Land and Water Resources

Southport Mall

P.O. Box 10631

Jackson, Mississippi 39209

CODED

WATER WELL DRILLERS LOG

Griner Drilling Service, Inc

Warren

Warren
1521
9/10/81

#9-10-81 date well completed

Griner Drilling Service, Inc firm name

Warren county well located

LANDOWNER:

Union Oil of California
3100 Cottage Hill Road
Suite 325
Mobile, Alabama 36616

description of formations encountered

from

to

<i>Top Soil</i>	<i>0</i>	<i>3</i>
<i>CLAY</i>	<i>3</i>	<i>20</i>
<i>SAND</i>	<i>20</i>	<i>42</i>
<i>SAND + CLAY STREAKS</i>	<i>42</i>	<i>265</i>
<i>SAND</i>	<i>265</i>	<i>280</i>
<i>CLAY + SAND STREAKS</i>	<i>280</i>	<i>310</i>
<i>CLAY - HARD</i>	<i>310</i>	<i>800</i>
<i>SAND (thin) + CLAY STREAKS</i>	<i>800</i>	<i>1104</i>

WELL LOCATION: *530'N 4575'W*

No 1 sec. 19 T. 17 R. 5 E of
Fried Redwood
Atkinson (distance) (direction) (nearest town)

WELL PURPOSE: *oil field supply*
 (home, irrigation, municipal)

WELL COMPLETION DATA:

- #1 Well* (1) diameter (inches) *3"*
- total depth (feet) *1104'*
- (3) static water level (feet) *150'* *below* top of ground *above*
- (4) casing *Steel, 1104'* (material) (depth)
- 3"* (size) if telescope see back.
- (5) screen *42', 1062'* (length) (depth to top)
- 3" perforated* (size) (material)
- (6) pump *6T-65* (HP) (yield gpm)
- AC* (type power)
- (7) electric log *—* (yes or no)
- (organization running log)

CODED

(8) how well bottom plugged *orange peel*

DRILLERS REMARKS:


DEPT. OF NATURAL RESOURCES
 BUREAU OF LAND & WATER RESOURCES

OCT - 1 1981

RECEIVED

If well telescopes please
sketch and show depths.

GROUND LEVEL

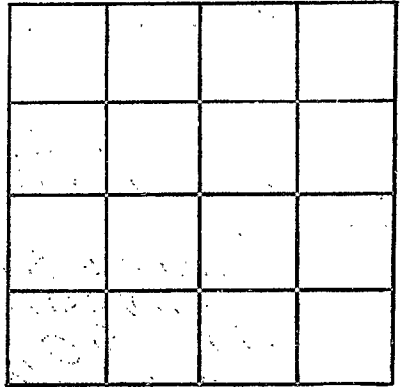

SECTION _____

Please indicate well location X.

ADDITIONAL INFORMATION

If more than one screen,
show locations of each on sketch.