

WARREN
 523
 7-15-82
 Elog #177

MISSISSIPPI
 BOARD OF WATER COMMISSIONERS
 416 North State Street
 Jackson, Mississippi 39201

CODED

WATER WELL DRILLERS LOG

Griner, Drilling
 Service, Inc.

Warren

date well completed

firm name

county well located

LANDOWNER:
 Exeter Drilling
 144 Elk Place
 Suite 1502
 New Orleans, La 70012
 (mailing address)

description of formations encountered	from to	
	ft	ft
chalk, sand, rock	0	400
chalk, shell	400	1200
sand, break of chalk, sand	1200	1286

WELL LOCATION: 2550 S 9 1865' W
 sec. 28 T 17 N R 5 E NE 1/4

1/4 mi. Anderson, Oak Ridge Field
 (distance) (direction) (nearest town)

WELL PURPOSE: oil field supply
 (home, irrigation, municipal, industrial)

CODED

WELL COMPLETION DATA:

- (1) diameter (inches) 3"
- (2) total depth (feet) 1286'
- (3) static water level (feet) 200' ^{below} _{above} top of ground.
- (4) casing steel 1286'
 (material) (depth)
 3" if telescope see back.
 (size)
- (5) screen 3" 1202'
 (length) (depth to top)
 3" perforated
 (size) (material)
- (6) pump — 70
 (HP) (yield gpm)
 (type power)
- (7) electric log Yes
 (yes or no)
 Bureau of Geology
 (organization running log)

DEPT. OF NATURAL RESOURCES
 BUREAU OF LAND & WATER RESOURCES


JUL 20 1982
 RECEIVED

(8) how well bottom plugged orange
 part

DRILLERS REMARKS:

If well telescopes please sketch and show depths.

GROUND LEVEL

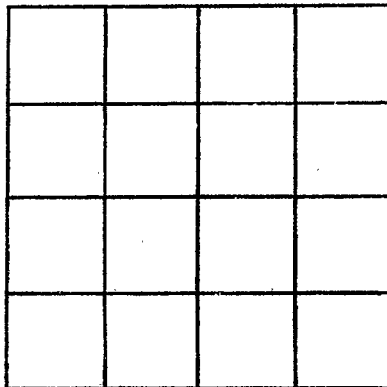

SECTION _____

Please indicate well location X.

ADDITIONAL INFORMATION

If more than one screen, show locations of each on sketch.