

MISSISSIPPI DEPARTMENT OF NATURAL RESOURCES

Bureau of Land and Water Resources

Southport Mall

P.O. Box 10631

Jackson, Mississippi 39209

WATER WELL DRILLERS LOG

CODED

WARREN
G 23

4-19-86 19 TOM GRIFFITH Well Service Warren
date well completed firm name county well located

LANDOWNER: DAVID NEW DRUG CO
P.O. Box 1487
Natchez Ms 39120
(mailing address)

WELL LOCATION:
sec. 17 T 17 N R 5 S
10 miles N of Vicksburg, Ms
(distance) (direction) (nearest town)

WELL PURPOSE: Oil location
(home, irrigation, municipal, industrial)


WELL COMPLETION DATA:

- (1) diameter (inches) 4 1/2
- (2) total depth (feet) 420
- (3) static water level (feet) >200 below top of ground.
- (4) casing PVC 380 (material) (depth)
N/A (size) if telescope see back.
- (5) screen 40 380 (length) (depth to top)
4" (size) PVC (material)
- (6) pump Air 40 (HP) (yield gpm)
beisel (type power)
- (7) electric log No (yes or no)
N/A (organization running log)
- (8) how well bottom plugged BW V

description of formations encountered	from	to
CLAY	0	85
Gravel	85	90
CLAY	90	190
Hard Rock	190	235
Sand	235	260
CLAY	250	260
SAND	260	270
CLAY	270	315
SAND	315	420

UNION EXPLORATION PARTNERS LTD.

#1 WALTER DEL'COR 17-11
1500' N E 1500' E OF SW 1 COR.

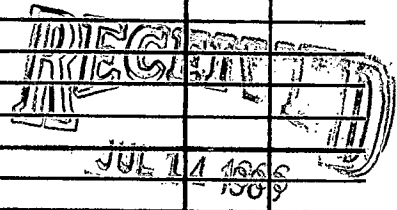


Department of Natural Resources
Bureau of Land and Water Resources

DRILLERS REMARKS:

If well telescopes please sketch and show depths.

GROUND LEVEL

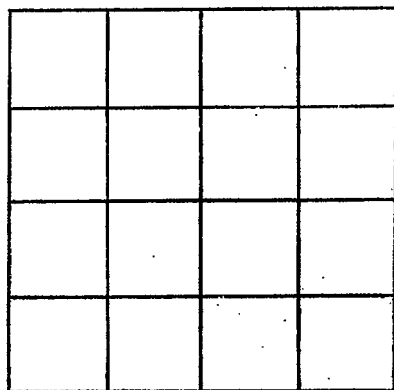

SECTION _____

Please indicate well location X.

ADDITIONAL INFORMATION

If more than one screen,
show locations of each on sketch.