

MISSISSIPPI DEPARTMENT OF NATURAL RESOURCES

Bureau of Land and Water Resources

Southport Mall

P.O. Box 10631

Jackson, Mississippi 39209

WATER WELL DRILLERS LOG

WARREN
G 27
8/88

August 1988 HERNDON WELL SUPPLY INC WARREN  
 date well completed firm name county well located


LANDOWNER: <u>CULKIN WATER ASSN</u>	description of formations encountered	from	to
<u>BIROSONG ROAD</u>			
<u>NICKSBURG, MISSISSIPPI</u> (mailing address)	<u>TOP SOIL + BROWN CLAY</u>	<u>0</u>	<u>20</u>
<u>WELL LOCATION:</u>	<u>BROWN CLAY</u>	<u>20</u>	<u>90</u>
sec. <u>35</u> T. <u>17</u> N. R. <u>5</u> E	<u>GRAY SILTY CLAY</u>	<u>90</u>	<u>150</u>
<u>10</u> miles <u>NE</u> of <u>NICKSBURG</u>	<u>GRAY CLAY</u>	<u>150</u>	<u>300</u>
(distance) (direction) (nearest town)	<u>GRAY SILT</u>	<u>300</u>	<u>350</u>
<u>WELL PURPOSE: municipal</u> (home, irrigation, municipal, industrial)	<u>GREEN CLAY</u>	<u>250</u>	<u>770</u>
<u>WELL COMPLETION DATA:</u>	<u>SILTY SAND</u>	<u>770</u>	<u>810</u>
(1) diameter (inches) <u>6"</u>	<u>BROWN CLAY</u>	<u>810</u>	<u>840</u>
(2) total depth (feet) <u>1336</u>	<u>BROWN SILTY SAND</u>	<u>840</u>	<u>900</u>
(3) static water level (feet) <u>123</u> below above top of ground.	<u>BROWN CLAY</u>	<u>900</u>	<u>960</u>
(4) casing <u>STEEL</u> , <u>1230</u> , (material) (depth) <u>6"</u> If telescope see back. (size)	<u>SILTY CLAY</u>	<u>960</u>	<u>1120</u>
(5) screen <u>100</u> , <u>1230</u> (length) (depth to top) <u>4</u> , <u>S. STEEL</u> (size) (material)	<u>HARD BROWN CLAY</u>	<u>1120</u>	<u>1200</u>
(6) pump _____ (HP) _____ (yield gpm) (type power)	<u>FINE GRAY SAND</u>	<u>1200</u>	<u>1270</u>
(7) electric log <u>YES</u> (yes or no) <u>HERNDON WELL SUPPLY</u> (organization running log)	<u>BROWN CLAY</u>	<u>1270</u>	<u>1310</u>
(8) how well bottom plugged <u>BACKWASH VALVE</u>	<u>FINE GRAY SAND</u>	<u>1310</u>	<u>1340</u>
<u>DRILLERS REMARKS:</u>	<u>DARK BROWN HARD CLAY</u>	<u>1340</u>	<u>1430</u>

RECEIVED  
 OCT 27 1988

Department of Natural Resources  
 Bureau of Land & Water Resources

If well telescopes please sketch and show depths.

GROUND LEVEL

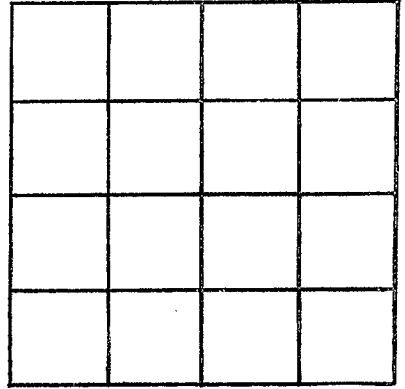

SECTION \_\_\_\_\_

Please indicate well location X.

ADDITIONAL INFORMATION

If more than one screen,  
show locations of each on sketch.