

MISSISSIPPI DEPARTMENT OF NATURAL RESOURCES

Bureau of Land and Water Resources

Southport Mall

P.O. Box 10631

Jackson, Mississippi 39209

WATER WELL DRILLERS LOG

W Warren  
G. 30

Coded

April 27 1990 Laure-Central Co. Warren  
date well completed firm name county well located


LANDOWNER: Culkin Water Dist  
Route 11 Box 29  
Vicksburg, MS 39180  
(mailing address)

WELL LOCATION:  
sec 25 T 17 N R 5 E  
SW 1/4 of SW 1/4 of SW 1/4  
(distance) miles (direction) of (nearest town)

WELL PURPOSE: Municipal  
(home, irrigation, municipal, industrial)

WELL COMPLETION DATA:  
(1) diameter (inches) 14" x 8"  
(2) total depth (feet) 1396  
(3) static water level (feet) 205 below above top of ground.  
(4) casing Steel, 1315'  
(material) (depth)  
14" if telescope see back.  
(size)  
(5) screen 70', 1320'  
(length) (depth to top)  
8", 304 Stainless Steel  
(size) (material)  
(6) pump 100 700  
(HP) (yield gpm)  
460 Volts  
(type power)  
(7) electric log Yes  
(yes or no)  
Laure-Central Co.  
(organization running log)  
(8) how well bottom plugged Back  
Pressure Valve

description of formations encountered	from	to
Brown Clay	0'	35'
Red Sand & Gravel	35'	89'
Sandy Gray Clay	89'	185'
Lime & Rock Streaks	185'	250'
Hard Shale	250'	295'
Sand & Shale Streaks	295'	330'
Hard Shale	330'	375'
Clay	375'	880'
Rock	880'	882'
Fine Sand & Clay	882'	925'
Clay & Sand Streaks	925'	1090'
Clay & Rock Streaks	1090'	1105'
Hard Clay	1105'	1135'
Sandy Clay & Lignite	1135'	1314'
Sand	1314'	1390'
Clay	1390'	1401'

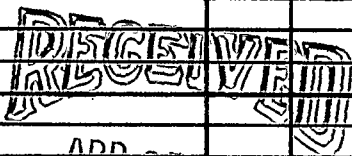


APR 25 1990

Dept. of Environmental Quality  
Bureau of Land & Water Resources

DRILLERS REMARKS:  
MS GW 12157

If well telescopes please sketch and show depths.

GROUND LEVEL

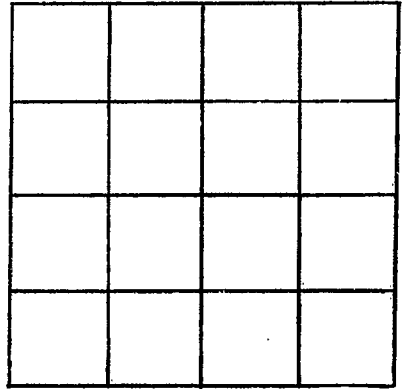

SECTION \_\_\_\_\_

Please indicate well location X.

ADDITIONAL INFORMATION

If more than one screen,  
show locations of each on sketch.