

WATER WELL DRILLERS LOG

OK 7/29/69

Warren
H 10
-63

Date: 12 March 1963, Driller: David Benny County Warren
(Name)

(1) Owner of Land: Yucca Valley, Inc.
(Name)
Redwood, Miss.
(Address)

(2) Location: 3 7 4
1/4, 1/4, Sec. T R
miles of
(distance) (direction) (Nearest Town)

(3) Topography: Flat
(Hilly) (Flat) (Level)

(4) Purpose of Well: Domestic
(Domestic Irrigation
Municipal, Industrial, Other)

Description & Color of Materials Sand, Clay, Red Clay, Shell, etc.	Thick- ness Feet	Depth Feet
clay	20	20
blue clay	35	55
lime rock	30	85
hard clay	57	142
sand	5	147
gumbo	13	160
sand	2	162
gumbo	5	167
sand	2	169
gumbo	246	415
sandy shale	10	425
gumbo	70	495
sandy shale	85	580
gumbo	60	640
sandy shale	20	660
gumbo	15	675
shale sandy	3	678
sand	20	698
sandy shale	27	725
sand	73	798

Information upon completion of well:

(1) Diameter 4x2 inches.

(2) Total Depth 798 feet.

(3) Water Level 12 feet below top of ground.
100' of 4"

(4) Cased to 6.38 4.2' Size


(5) Screen: Size 2, Length 40

(6) Were any formations sealed against pollution?
_____ yes, _____ no.

If YES depth of formation _____

Why _____

Drillers Remarks: _____

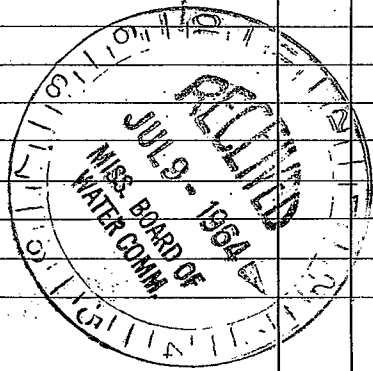

(Use Back Side)

Well No.

