

MISSISSIPPI DEPARTMENT OF NATURAL RESOURCES  
 Bureau of Land and Water Resources  
 Southport Mall  
 P.O. Box 10631  
 Jackson, Mississippi 39209  
**WATER WELL DRILLERS LOG**

**CODED**

Warren  
 J 15  
 7-1-78

07-1-78 DRIVER DRILLING SERVICE WARREN  
 date well completed firm name county well located

LANDOWNER: ERSON INC.  
 WELL No. 1  
 (mailing address)

description of formations encountered	from	to
TOP SOIL	0	3
SAND	3	18
CLAY	18	42
SAND & Gravel	42	190

WELL LOCATION: NE 1/4 SW 1/4  
 sec. 4 T. 16 N. R. 3 E.  
 S W  
 miles of (distance) (direction) (nearest town)

WELL PURPOSE: Industrial  
 (home, irrigation, municipal, industrial)

- WELL COMPLETION DATA:
- (1) diameter (inches) 6
  - (2) total depth (feet) 122 ft.
  - (3) static water level (feet) 33 below top of ground.
  - (4) casing steel, 90 ft.  
 (material) (depth)  
6 3/8" if telescope see back.  
 (size)
  - (5) screen 30 ft., 92  
 (length) (depth to top)  
6", 304 S.S.  
 (size) (material)
  - (6) pump 5 100  
 (HP) (yield gpm)  
Elect.  
 (type power)
  - (7) electric log yes  
 (yes or no)  
MISS GEOL. SURVEY  
 (organization running log)
  - (8) how well bottom plugged BACK  
WASH VALVE

DRILLERS REMARKS:


DEPT. OF NATURAL RESOURCES  
 BUREAU OF LAND & WATER RESOURCES

FEB 22 1982

**RECEIVED**

If well telescopes please sketch and show depths.

GROUND LEVEL

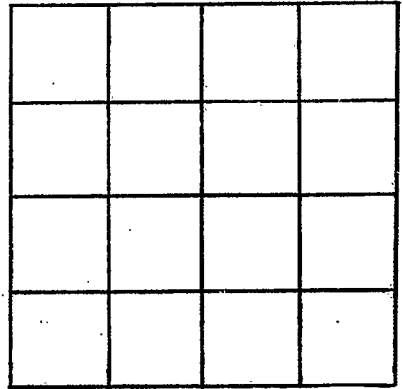

SECTION \_\_\_\_\_

Please indicate well location X.

ADDITIONAL INFORMATION

If more than one screen,  
show locations of each on sketch.