

Warren  
 T 20  
 4-66  
 Elec Log  
 April 1966 19

MISSISSIPPI  
 BOARD OF WATER COMMISSIONERS  
 416 North State Street  
 Jackson, Mississippi 39201

WATER WELL DRILLERS LOG

Robert E. Keady Warren  
 date well completed firm name county well located

LANDOWNER: Anderson-  
 Clayton C.  
 Vicksburg, Miss  
 (mailing address)


description of formations encountered	from	to
Top Sand	0	25
Blue clay	25	50
Sand	50	100
Fine gravel + Sand	100	135
white clay	135	196

WELL LOCATION:  
 sec. 3 T. 16 N. R. 3 E.  
 S W  
 2 miles N.W. of Vicksburg  
 (distance) (direction) (nearest town)

WELL PURPOSE:  
 (home, irrigation, municipal, industrial)

WELL COMPLETION DATA:

(1) diameter (inches) 20 x 12  
 (2) total depth (feet) 135  
 (3) static water level (feet) 16 below top of ground.  
 (4) casing St. 115 (material), (depth)  
 20 x 12 (size) if telescope see back.  
 (5) screen 20 115 (length), (depth to top)  
 .040 S.S. (size), (material)  
 (6) pump 100 1600 (HP), (yield gpm)  
 turbine (type power)  
 (7) electric log Yes (yes or no)  
 U.S. G.S. (organization running log)  
 (8) how well bottom plugged Steel plate - welded

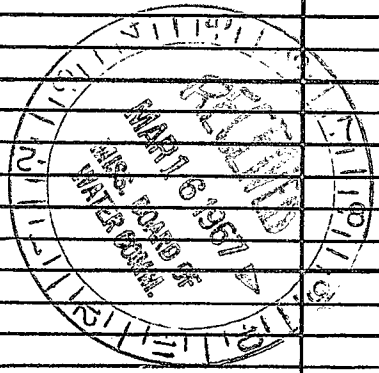

DRILLERS REMARKS:

