

WELL NO. 1

6W-4783

MISSISSIPPI

BOARD OF WATER COMMISSIONERS

416 North State Street

Jackson, Mississippi 39201

WATER WELL DRILLERS LOG

CODE

Warren

T 21

9-66

September 9, 1966 Layne-Central Company, Warren

date well completed

firm name

county well located

LANDOWNER: City of

Vicksburg,

Vicksburg, Mississippi

(mailing address)

description of formations encountered

from

to

Fill, Sand & Clay

0 16

Hard Black Clay

16 22

Soft Clay

22 35

Hard Blue Clay

35 45

Soft Blue Clay

45 107

Soft Sandy Clay

107 120

Sand & Gravel

120 148

Coarse Sand, & Clay

_____ miles _____ of _____
(distance) (direction) (nearest town)

Streaks

148 167

WELL PURPOSE: municipal
(home, irrigation, municipal, industrial)

Coarse Sand, little clay

167 180

Sand & Gravel, little

Clay Streaks

180 187

WELL COMPLETION DATA:

- (1) diameter (inches) 30"
- (2) total depth (feet) 187'
- (3) static water level (feet) 51' below top of ground.

- (4) casing 30" (material), 141' (depth)

_____ if telescope see back.
(size)

- (5) screen 40' (length), 141' (depth to top)

20" (size), stainless steel (material)

- (6) pump 100 (HP), 1400 (yield gpm)

electric
(type power)


- (7) electric log no (yes or no)

_____ (organization running log)

- (8) how well bottom plugged valve

DRILLERS REMARKS:
Test conducted with test pump.

CODED

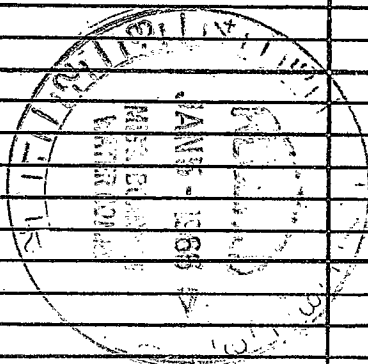

(X)

If well telescopes please sketch and show depths.

GROUND LEVEL

X			

SECTION 2

Please indicate well location X.

ADDITIONAL INFORMATION

If more than one screen, show locations of each on sketch.