

GW-4784

WELL NO. 2

MISSISSIPPI
BOARD OF WATER COMMISSIONERS
416 North State Street
Jackson, Mississippi 39201

WATER WELL DRILLERS LOG

CODED

September 22, 1966 Layne-Central Company, Warren
date well completed firm name county well located

LANDOWNER: City of
Vicksburg,

description of formations
encountered

from to

Gumbo 0 20

Clay 20 30

Fine Blue Sand 30 37

Sand & Clay Streaks 37 57

Soft Sand & Clay 57 66

Coarse Sand & Clay 66 101

Coarse Sand & Gravel 101 117

Sand, Gravel, little
Clay Streaks 117 127

Coarse Sand 127 142

Blue Clay 142 147

Vicksburg, Mississippi
(mailing address)

WELL LOCATION:

sec. 3 T. 16 N. R. 3 E
S. W.

(distance) miles of (direction) of (nearest town)

WELL PURPOSE: municipal
(home, irrigation, municipal, industrial)

WELL COMPLETION DATA:

(1) diameter (inches) 30"

(2) total depth (feet) 146'

(3) static water level (feet) 28' below
top of ground.

(4) casing 30" 100'
(material) (depth)

(size) If telescope see back.

(5) screen 40' 100'
(length) (depth to top)

20" stainless steel
(size) (material)

(6) pump 100 1400
(HP) (yield gpm)

electric
(type power)

(7) electric log no
(yes or no)


(organization running log)

(8) how well bottom plugged

DRILLERS REMARKS:

Test conducted with test pump

CODED

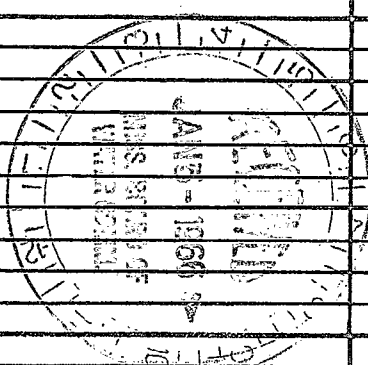



If well telescopes please sketch and show depths.

GROUND LEVEL

	X		

SECTION 3

Please indicate well location X.

ADDITIONAL INFORMATION

If more than one screen, show locations of each on sketch.