

GW-4785

WELL NO. 3

MISSISSIPPI
BOARD OF WATER COMMISSIONERS
416 North State Street
Jackson, Mississippi 39201

WATER WELL DRILLERS LOG

CODED

Warren
T 23
10-66

October 4, 1966 Layne-Central Company, Warren
date well completed firm name county well located

LANDOWNER: City of

Vicksburg,

Vicksburg, Mississippi
(mailing address)

WELL LOCATION:

sec. 3 T. 16 N. R. 3 E. S. W

(distance) miles of (direction) (nearest town)

WELL PURPOSE: municipal
(home, irrigation, municipal, industrial)

WELL COMPLETION DATA:


- (1) diameter (inches) 30"
- (2) total depth (feet) 151'
- (3) static water level (feet) 2.6' below top of ground.
- (4) casing 30" (material), 100' (depth)
- (size) If telescope see back.
- (5) screen 20" x 40' (length), 100' (depth to top)
- 20" stainless steel (size) (material)
- (6) pump 100 (HP), 1400 (yield gpm)
- electric (type power)
- (7) electric log no (yes or no)
- (organization running log)
- (8) how well bottom plugged

description of formations encountered

from to

Hard Black Clay	0	15
Gray Clay, Soft	15	29
Fine Blue Sand	29	33
Soft Clay	33	39
Sandy Clay	39	53
Soft Clay, Sand Stks.	53	61
Fine & Coarse Sand	61	68
Coarse Sand, Clay Streaks	68	88
Coarse Sand, Little Clay Streaks	88	107
Coarse Sand & Gravel	107	147
Blue Clay	147	157

CODED

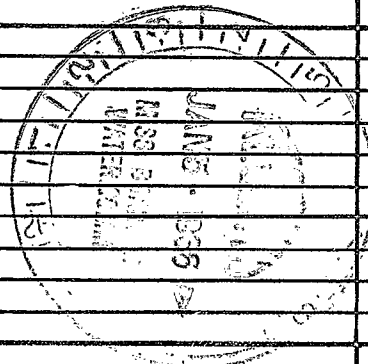

DRILLERS REMARKS:

Test conducted with test pump

(K)

If well telescopes please sketch and show depths.

GROUND LEVEL

	X		

SECTION 3

Please indicate well location X.

ADDITIONAL INFORMATION

If more than one screen, show locations of each on sketch.