

Well no. 6

GW 5788

MISSISSIPPI  
BOARD OF WATER COMMISSIONERS  
416 North State Street  
Jackson, Mississippi 39201

CODED

Warren  
J 26  
9-25-68

WATER WELL DRILLERS LOG

9-25-1968 date well completed  
Layne Central Company firm name  
Warren county well located

LANDOWNER:  
City of Vicksburg  
Vicksburg, Miss.  
(mailing address)

description of formations encountered	from	to
Fill Dirt	0	8
Clay	8	37
Fine Sandy Clay	37	47
Fine Sand	47	57
Fine Sand	57	67
Fine Sand	67	77
Sand	77	97
Coarse Sand	97	107
Sand and gravel	107	126
Clay	126	132


WELL LOCATION: North well line  
sec. 2 T 16 N R 3 E  
SW 1/4 NW 1/4  
miles of (distance) (direction) (nearest town)

WELL PURPOSE: Municipal  
(home, irrigation, municipal, industrial)

WELL COMPLETION DATA:

- (1) diameter (inches) 30"
- (2) total depth (feet) 132'
- (3) static water level (feet) 25' below top of ground.
- (4) casing Steel 86' (material) (depth)  
30" x 24" if telescope see back. (size)
- (5) screen 40' 86' (length) (depth to top)  
30" Stainless Steel (size) (material)
- (6) pump 100 (HP) (yield gpm)  
Electric (type power)
- (7) electric log No (yes or no)  
(organization running log)
- (8) how well bottom plugged 6" staples  
Steel Blank

CODED

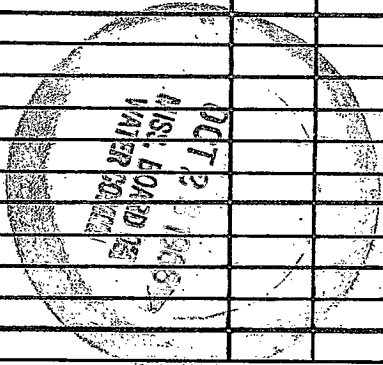


DRILLERS REMARKS:  
Pump not installed as of this date

(X)

If well telescopes please sketch and show depths.

GROUND LEVEL

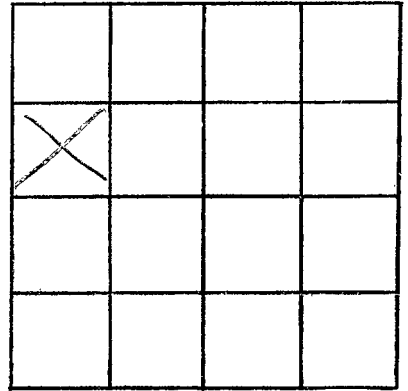

SECTION 2

Please indicate well location X.

ADDITIONAL INFORMATION

If more than one screen, show locations of each on sketch.