

well no. 10

CODED

MISSISSIPPI BOARD OF WATER COMMISSIONERS 416 North State Street Jackson, Mississippi 39201

WATER WELL DRILLERS LOG

CODED

Warren 527 10-1-68

10-1 date well completed 1968 firm name county well located

LANDOWNER: City of Vicksburg Vicksburg, Miss. (mailing address)

Table with 4 columns: description of formations encountered, from, to. Rows include: fill (0-7), Blue Clay (7-20), Fine Sand (20-32), Blue Clay, Sand, Silt (32-53), Soft Blue Clay (53-64), Flow Sand (64-77), Sand (77-87), Coarse Sand (87-93), Sand and Gravel (93-115), Blue Clay (115-132)


WELL LOCATION: South well line sec. 3 T. 16 N R. 3 E S SW 1/4 NW 1/4 (distance) miles of (direction) (nearest town)

WELL PURPOSE: Municipal (home, irrigation, municipal, industrial)

WELL COMPLETION DATA:

- (1) diameter (inches) 30"
(2) total depth (feet) 119'
(3) static water level (feet) 25' below top of ground.
(4) casing Steel 73' (material) (depth) 30" x 24" if telescope see back. (size)
(5) screen 40' 73' (length) (depth to top) 20" Stainless Steel (size) (material)
(6) pump 100 (HP) (yield gpm) Electric (type power)
(7) electric log No (yes or no)
(organization running log)
(8) how well bottom plugged St. Steel Solid Bottom

CODED

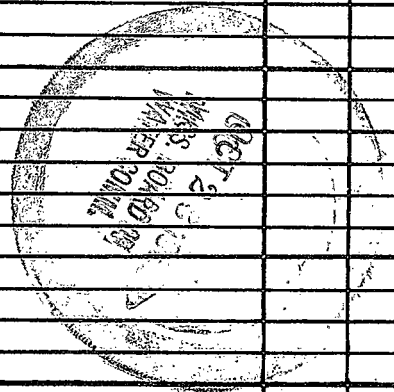

DRILLERS REMARKS:

Pump not installed as of this date

