

well no. 9

GW-4791

Warren  
J 20  
10-11-68

MISSISSIPPI  
BOARD OF WATER COMMISSIONERS  
416 North State Street  
Jackson, Mississippi 39201

CODED

WATER WELL DRILLERS LOG

10-11-68 date well completed  
Leynd-Central Co. firm name  
Warren county well located

LANDOWNER:

City of Vicksburg  
Vicksburg, Miss  
(mailing address)

description of formations encountered

from to

Breakshot Clay 0 20'  
Blue Clay 20 56'  
Gray Sand 56 95'  
Sand and Gravel 95 167'  
Clay 167 170'

CODED

WELL LOCATION: South line - New Well Field

sec. 3 T 16 S R 3 E  
SE 1/4 & NW 1/4  
miles of (distance) (direction) (nearest town)


WELL PURPOSE: Municipal (home, irrigation, municipal, industrial)

WELL COMPLETION DATA:

- (1) diameter (inches) 30"
- (2) total depth (feet) 163'
- (3) static water level (feet) 26' below top of ground.
- (4) casing Steel, 117' (material) (depth)  
30" x 24" if telescope see back. (size)
- (5) screen 40' length, 117' depth to top  
20" Stainless Steel (size) (material)
- (6) pump 100 (HP) (yield gpm)  
Electric (type power)
- (7) electric log NO (yes or no)

CODED

CODED

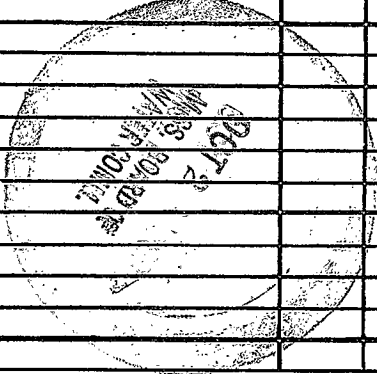

(organization running log)

(8) how well bottom plugged 6' Stankies  
steel BLANK, solid bottom

DRILLERS REMARKS:  
Pump not installed  
as of this date.

(X)

If well telescopes please sketch and show depths.

GROUND LEVEL


SECTION 3

Please indicate well location X.

ADDITIONAL INFORMATION

If more than one screen, show locations of each on sketch.