

GW - 4790

Well No. 8

Warren  
T 29  
10-68

MISSISSIPPI  
BOARD OF WATER COMMISSIONERS  
416 North State Street  
Jackson, Mississippi 39201

**CODED**

WATER WELL DRILLERS LOG

10-15-1968  
date well completed

Rayner Central Co  
firm name

Warren  
county well located

LANDOWNER:

City of Vicksburg  
Vicksburg, Miss.  
(mailing address)

description of formations encountered

from to

Fill	0	6
Clay	6	27
Blue Clay	27	64
Green Sand	64	77
Light Sand	77	132
Blue Clay	132	137

WELL LOCATION: South Line


sec. 3 T 16 N R 3 E  
S W  
(distance) miles (direction) of (nearest town)

WELL PURPOSE:  
(home, irrigation, municipal, industrial)

WELL COMPLETION DATA:

- (1) diameter (inches) 30"
- (2) total depth (feet) 141'
- (3) static water level (feet) 25' below top of ground
- (4) casing Steel, 95' (depth)  
30" (size) if telescope see back.
- (5) screen 40' (length), 95' (depth to top)  
20" (size), Stainless Steel (material)
- (6) pump 100 (HP) (yield gpm)  
Electric (type power)
- (7) electric log No (yes or no)  
(organization running log)

**CODED**

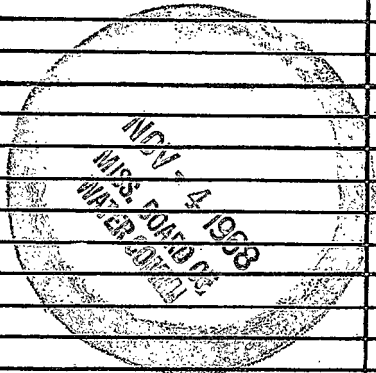

(8) how well bottom plugged: Stainless Steel Solid Bottom

DRILLERS REMARKS:

Pump not installed as of this date

(X)

If well telescopes please sketch and show depths.

GROUND LEVEL

			X

SECTION 3

Please indicate well location X.

ADDITIONAL INFORMATION

If more than one screen, show locations of each on sketch.