

Well no. 7

Warren
F 30
10-68
GW-4789

MISSISSIPPI
BOARD OF WATER COMMISSIONERS
416 North State Street
Jackson, Mississippi 39201

CODED

WATER WELL DRILLERS LOG

10-25-1968 date well completed Layne-Central Co. firm name Warren county well located

LANDOWNER:

City of Vicksburg
Vicksburg, Miss
(mailing address)

description of formations encountered

from to

<u>Buckshot Clay</u>	<u>0</u>	<u>17</u>
<u>Blue Clay</u>	<u>17</u>	<u>72</u>
<u>Sand and Gravel</u>	<u>72</u>	<u>87</u>
<u>Sand</u>	<u>87</u>	<u>105</u>
<u>Sand and Gravel</u>	<u>105</u>	<u>167</u>
<u>Clay</u>	<u>167</u>	<u>169</u>

WELL LOCATION:

South Well Line
sec. 2 T 16 N R 3 E
S W


_____ miles _____ of _____
(distance) (direction) (nearest town)

WELL PURPOSE: Municipal
(home, irrigation, municipal, industrial)

WELL COMPLETION DATA:

- (1) diameter (inches) 30"
- (2) total depth (feet) 161'
- (3) static water level (feet) 27'6" below top of ground.
- (4) casing Steel, 115'
(material) (depth)
30" if telescope see back,
(size)
- (5) screen 40', 115'
(length) (depth to top)
20", Stimber Steel
(size) (material)
- (6) pump 100 (HP) (yield gpm)
Electric
(type power)
- (7) electric log no
(yes or no)

CODED

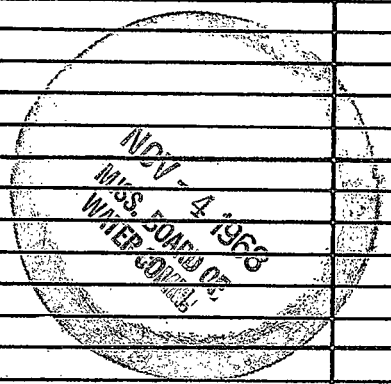

_____ (organization running log)

(8) how well bottom plugged St. Steel
Solid Ballon

DRILLERS REMARKS:

Pump not installed as of this date.



If well telescopes please
sketch and show depths.

GROUND LEVEL

X			

SECTION 2

Please indicate well location X.

ADDITIONAL INFORMATION

If more than one screen,
show locations of each on sketch.