

Well No. 5

Warren
J 32
9-9-68
GW-4787

MISSISSIPPI
BOARD OF WATER COMMISSIONERS
416 North State Street
Jackson, Mississippi 39201

CODED
CODED

WATER WELL DRILLERS LOG

9-9-1968 date well completed
Layne's Central Company firm name
Warren county well located

LANDOWNER:

City of Vicksburg
Vicksburg, Miss.
(mailing address)

description of formations encountered

from to

Clay	0	37
Fine Sand & Clay	37	55
Sand and Little Gravel	55	67
" " " "	67	77
" " " "	77	87
Sand and Gravel	87	97
" " " "	97	107
" " " "	107	117
" " " "	117	127
" " " "	127	139
Blue Clay	139	147

WELL LOCATION: New Well Field


sec 2 T 16 N R 3 E
3
miles of (distance) (direction) (nearest town)

WELL PURPOSE: Municipal
(home, irrigation, municipal, industrial)

WELL COMPLETION DATA:

- (1) diameter (inches) 30"
- (2) total depth (feet) 142'
- (3) static water level (feet) 22' below top of ground.
- (4) casing Steel, 88' 8" (material) (depth)
30" (size) If telescope see back.
- (5) screen 40' 96' (length) (depth to top)
20" Stainless Steel (size) (material)
with 10' stainless steel Blank
- (6) pump 100 (HP) (yield gpm)
Electric (type power)
- (7) electric log no (yes or no)
(organization running log)
- (8) how well bottom plugged Solid Bottom

CODED
CODED

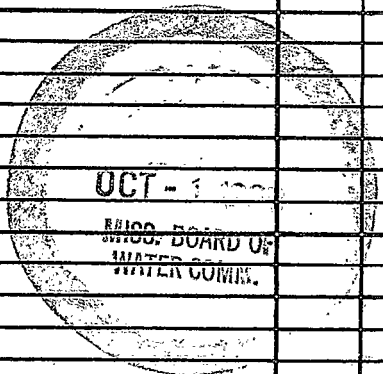


DRILLERS REMARKS:

Pump not installed as of this date, no test run.

If well telescopes please sketch and show depths.

GROUND LEVEL

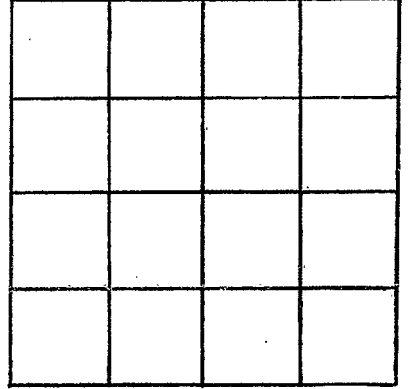

SECTION _____

Please indicate well location X.

ADDITIONAL INFORMATION

If more than one screen, show locations of each on sketch.