

well no. 4

GW - 4786

Warren
J 33
9-19-68

MISSISSIPPI
BOARD OF WATER COMMISSIONERS
416 North State Street
Jackson, Mississippi 39201

CODED

WATER WELL DRILLERS LOG

9-19-68 date well completed
Layne-Central Co. firm name
Warren county well located

LANDOWNER:
City of Vicksburg
Vicksburg, Miss.
(mailing address)

description of formations encountered	from	to
Clay	0	57
Sand	57	67
Sand	67	77
Sand	77	93
Sand gravel	93	107
" " "	107	117
" " "	117	127
" " "	127	137
" " "	137	146
Blue Clay	146	148


WELL LOCATION: NEW Well Field
sec. 2 T. 16 N R. 3 E
S W
miles of (distance) (direction) (nearest town)

WELL PURPOSE: Municipal
(home, irrigation, municipal, industrial)

WELL COMPLETION DATA:
(1) diameter (inches) 30"
(2) total depth (feet) 143'
(3) static water level (feet) 22' below top of ground.
(4) casing Steel 89' (material) (depth)
(size) if telescope see back.

CODED

(5) screen 40' 99' (length) (depth to top)
20" stainless steel
with 10" (size) stainless material blank
(6) pump 100 (HP) (yield gpm)
Electric (type power)

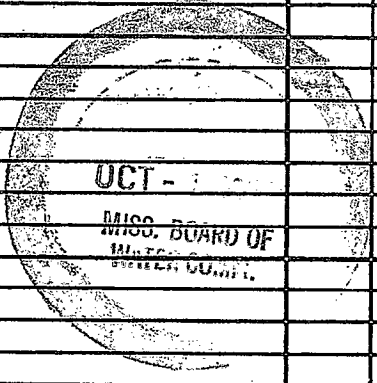

(7) electric log NO (yes or no)
(organization running log)

(8) how well bottom plugged Solids Ballon

DRILLERS REMARKS:

Pump not installed as of this date - no test run

