

MISSISSIPPI DEPARTMENT OF NATURAL RESOURCES

Bureau of Land and Water Resources

Southport Mall

P.O. Box 10631

Jackson, Mississippi 39209

WATER WELL DRILLERS LOG

WARREN
541

Sept. 4 1986 E.M. Bud Cresswell WARREN
 date well completed firm name county well located

LANDOWNER: Monitor No. 2
City of Vicksburg
Vicksburg, MS.
 (mailing address)

description of formations encountered	from	to
	<u>Surface</u>	<u>0</u>
<u>brown - Band</u>	<u>20</u>	<u>37</u>
<u>gray - Band</u>	<u>37</u>	<u>85</u>

WELL LOCATION:
 sec 3 T 16 N R 3 E
at Vicksburg
 (distance) miles (direction) of (nearest town)

WELL PURPOSE: Monitor Well
 (home, irrigation, municipal, industrial)

- WELL COMPLETION DATA:
- (1) diameter (inches) 3
 - (2) total depth (feet) 85
 - (3) static water level (feet) 18 below above top of ground.
 - (4) casing PVC 75
 (material) (depth)
 - 3 if telescope see back.
 (size)
 - (5) screen 10 75
 (length) (depth to top)
3 PVC
 (size) (material)
 - (6) pump none
 (HP) (yield gpm)
 (type power)
 - (7) electric log No
 (yes or no)
 (organization running log)
 - (8) low well bottom plugged
back wash


RECEIVED
 SEP 18 1986

Department of Natural Resources
 Bureau of Land & Water Resources

DRILLERS REMARKS: Monitor
Well for observing
water level in well
field

If well telescopes please sketch and show depths.

GROUND LEVEL

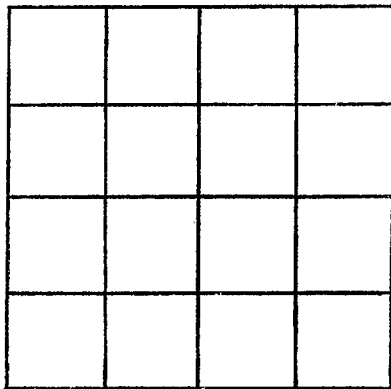

SECTION _____

Please indicate well location X.

ADDITIONAL INFORMATION

If more than one screen,
show locations of each on sketch.