

MISSISSIPPI DEPARTMENT OF NATURAL RESOURCES

Bureau of Land and Water Resources

Southport Mall

P.O. Box 10631

Jackson, Mississippi 39209

WATER WELL DRILLERS LOG

STEVE GARDNER  
 WATER WELLS  
 WARREN  
 J 42

Coded

9 25 1988 OLD RIVER HUNTING CLUB - WARREN  
 date well completed firm name county well located

LANDOWNER:	description of formations encountered	from	to
OLD RIVER HUNTING CLUB	SAND & PLEISTOCENE	0	50
	WATER SAND	50	160
	CLAY	160	630
	SAND	630	690
	SAND, SHELL, LIMITE	690	740
	SAND	740	790
	SAND CLAY, SHELL, LIMITE.	790	965

(mailing address)

WELL LOCATION:  
 sec. 1 T. 76 N R. 2 E  
 S W  
 15 miles NE 1/4 of VIBURNA  
 (distance) (direction) (nearest town)

WELL PURPOSE: HOME  
 (home, irrigation, municipal, industrial)

WELL COMPLETION DATA:

(1) diameter (inches) 4"

(2) total depth (feet) 965

(3) static water level (feet) 50 below above top of ground.

(4) casing P.V.C. 720  
 (material) (depth)

(size) if telescope see back.

(5) screen 80 660 to 740 to 790  
 (length) (depth to top)

4" P.V.C.  
 (size) (material)

(6) pump 3 40  
 (HP) (yield gpm)

A C  
 (type power)

(7) electric log YES  
 (yes or no)

GEOLOGICAL  
 (organization running log)

(8) how well bottom plugged BACK  
 WASH VAL

RECEIVED



MAR 03 1989

Department of Natural Resources  
 Bureau of Land & Water Resources

DRILLERS REMARKS:

If well telescopes please sketch and show depths.

GROUND LEVEL

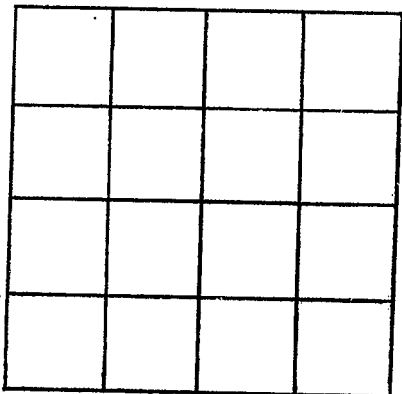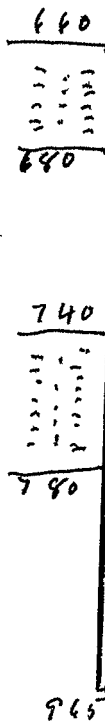

SECTION 1

Please indicate well location X.

ADDITIONAL INFORMATION

IF I DRILL ANOTHER WELL THAT DEEP I WOULD DROP THE TOP SCREEN SAND TO FINE

If more than one screen, show locations of each on sketch.