

WARREN
 J 2001
 12-30-75

MISSISSIPPI
 BOARD OF WATER COMMISSIONERS
 416 North State Street
 151 Jackson, Mississippi 39201

WATER WELL DRILLERS LOG

Dec - 30 - 75 DeFord Drilling Co Warren
 date well completed firm name county well located

LANDOWNER:
International Paper Co
Ruckelberg, MS
 (mailing address)

description of formations encountered
Clay
sand
 from to
0 12
12 95

WELL LOCATION:
 sec. 12 T. 16 N. R. 3 E.
 S W.
3 miles n/w of Ruckelberg
 (distance) (direction) (nearest town)

1/4 mile west of
Falk Steel

WELL PURPOSE: Industrial
 (home, irrigation, municipal, industrial)

- WELL COMPLETION DATA:
- (1) diameter (inches) 2"
 - (2) total depth (feet) 95
 - (3) static water level (feet) 16 below above top of ground.
 - (4) casing PVC, 95
 (material) (depth)
 (size) if telescope see back.
 - (5) screen 12, 83
 (length) (depth to top)
2", PVC
 (size) (material)
 - (6) pump 3/4, 10
 (HP) (yield gpm)
AC
 (type power)
 - (7) electric log no
 (yes or no)
 (organization running log)
 - (8) how well bottom plugged each wash valve


RECEIVED
 JUL 9 1978

MISS. Bd. OF WATER COMMISSIONERS

DRILLERS REMARKS:

If well telescopes please sketch and show depths.

GROUND LEVEL

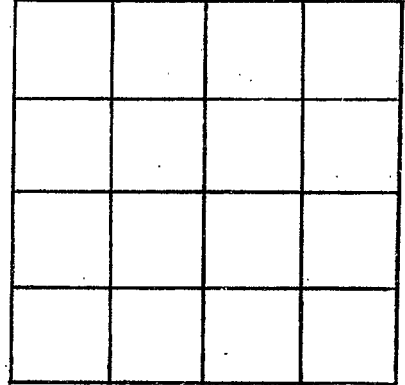

SECTION _____

Please indicate well location X.

ADDITIONAL INFORMATION

If more than one screen, show locations of each on sketch.