

MISSISSIPPI DEPARTMENT OF NATURAL RESOURCES

Bureau of Land and Water Resources

Southport Mall

P.O. Box 10631

Jackson, Mississippi 39209

WATER WELL DRILLERS LOG

J 2002  
Warren  
10-11-85

Oct. 11 1985 E.M. Bud Cresswell Warren  
date well completed firm name county well located


LANDOWNER:	description of formations encountered	from	to
Linwood Nooe			
JACKSON, MS. (mailing address)	Surface - R&D	0 15	15 110
WELL LOCATION: sec. 16 T 19 N R 3 E on Kings Point Island (distance) miles (direction) of (nearest town)			
WELL PURPOSE: Camp (home, irrigation, municipal, industrial)			
WELL COMPLETION DATA:			
(1) diameter (inches) 4			
(2) total depth (feet) 110			
(3) static water level (feet) 30 below top of ground.			
(4) casing PVC 90 (material) (depth) 4 (size) if telescope see back.			
(5) screen 20 90 (length) (depth to top) 4 PVC (size) (material)			
(6) pump 1 20 (HP) (yield gpm) (type power)			
(7) electric log No (yes or no) (organization running log)			
(8) how well bottom plugged Back wash valve			
DRILLERS REMARKS:			

RECEIVED  
OCT 17 1985

Department of Natural Resources  
Bureau of Land & Water Resources

If well telescopes please sketch and show depths.

GROUND LEVEL

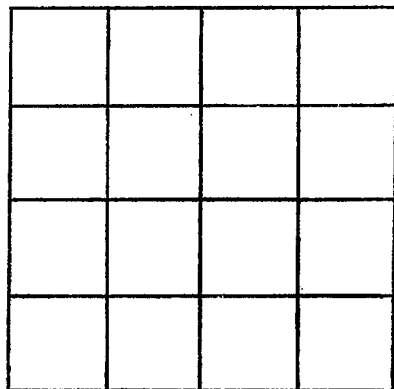

SECTION \_\_\_\_\_

Please indicate well location X.

ADDITIONAL INFORMATION

If more than one screen,  
show locations of each on sketch.