

MISSISSIPPI DEPARTMENT OF NATURAL RESOURCES
Bureau of Land and Water Resources
 Southport Mall
 P.O. Box 10631
 Jackson, Mississippi 39209
WATER WELL DRILLERS LOG

WARREN
J 2003

Aug. 12 1986 E.M. Bud CRESSWELL WARREN
 date well completed firm name county well located


LANDOWNER: Well No. 1
Brown's Point Assn.
Vicksburg, MS.
 (mailing address)

description of formations encountered	from	to
	<u>Surface</u>	<u>0</u>
<u>Sand - gravel</u>	<u>30</u>	<u>130</u>

WELL LOCATION:
 sec. 2 T. 16 N. R. 3 E
Kings Point Island
 (distance) miles (direction) of (nearest town)

WELL PURPOSE: Camp
 (home, irrigation, municipal, industrial)

- WELL COMPLETION DATA:
- (1) diameter (inches) 4
 - (2) total depth (feet) 130
 - (3) static water level (feet) 22 below top of ground
 - (4) casing PVC 110
 (material) (depth)
4 if telescope see back.
 (size)
 - (5) screen 20 110
 (length) (depth to top)
4 PVC
 (size) (material)
 - (6) pump 1 20
 (HP) (yield gpm)
 (type power)
 - (7) electric log No
 (yes or no)
 (organization running log)
 - (8) how well bottom plugged
Back Wash

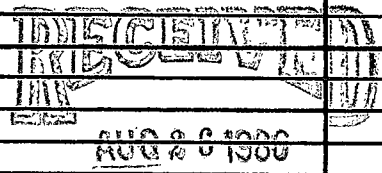


Department of Natural Resources
 Bureau of Land & Water Resources

DRILLERS REMARKS:

If well telescopes please sketch and show depths.

GROUND LEVEL

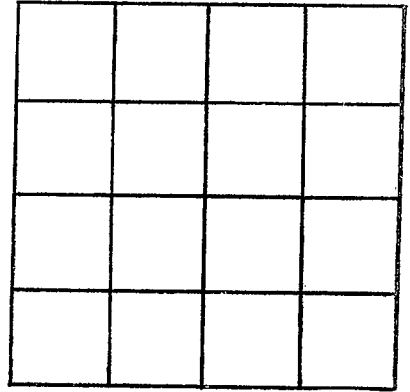

SECTION _____

Please indicate well location X.

ADDITIONAL INFORMATION

If more than one screen,
show locations of each on sketch.