

MISSISSIPPI DEPARTMENT OF ENVIRONMENTAL QUALITY

Office of Land and Water Resources

P. O. Box 10631
Jackson, MS 39289-0631

WATER WELL DRILLERS LOG

COUNTY WELL LOCATED
WARREN

WELL NUMBER **2004** CODED

DATE WELL COMPLETED
Aug 2, 1996

PERMIT NUMBER

NAME OF DRILLING FIRM
E.M. DUD CRESSWELL

BENTONIA, MS

NAME & MAILING ADDRESS OF LANDOWNER
Polymerc USA, Inc.
Vicksburg, MS

WELL LOCATION: SEC **3** TOWNSHIP **16** RANGE **N 3 E**

DISTANCE **AT PART of** DIRECTION **VICKSBURG** NEAREST TOWN

OTHER LANDMARK

WELL PURPOSE: Home, Irrigation, Municipal, Industrial, Fish Pond, etc.

PUMP DATA

PUMP TYPE (Circle One):
Submersible, Hand Pump, Jet, Flowing Well,
Other (Describe) **No Pump**

POWER TYPE (Circle One):
Electric, Tractor, Diesel, Gasoline, Butane,
Other (Describe) **H/P**

Pump Capacity (GPM) No. of Stages Setting Depth **FT.**

PUMP TEST
Well yielded **50** GPM with
a drawdown of **15** ft.
after **2** hours of pumping

WELL DATA

Well Depth **115** Casing Diameter (In.) **4** Casing Length (Ft.) **75**

Type of Casing **PVC** Hole Depth **115** Depth to Static Water Level **40**

TYPE OF COMPLETION: (Circle One or More):
Gravel Packed, Underreamed, Telescoped,
Natural Development, Open Hole, Other

WELL GROUTED TO A DEPTH OF **25** FEET
Type Grout (circle one): Cement, Bentonite or Mix

SCREEN DATA

Diameter - Inches **4** Length - Feet **40** Slot Size - Inches **.016**

Screen Type **PVC** Depth to Bottom - Feet **115**

LOG DATA

TYPE OF LOG RUN (Circle One): No Log Run,
Electric, Gamma Ray, Density, Sonic, Neutron,
Other (Describe)

Name of Organization Running Log

GEOLOGIC DATA (Office Use Only)

Surface Elev.	Geologic Unit	Unit Thickness	Depth to Top
Subs. SWL	Date	Analysis	Aquifer Test

Driller's Remarks

Top of Lap Pipe or Reduction in Casing

FEET IF TELESCOPED OR MORE THAN ONE SCREEN: USE BACK PAGE

DESCRIPTION OF FORMATIONS ENCOUNTERED	FROM	TO
SAND	0	38
gumbo	38	45
SAND-GRAVEL	45	115

FORMATIONS (Continued)

FROM TO

RECEIVED


AUG 28 1996

Dept. of Environmental Quality
Office of Land & Water Resources

IF MORE SPACE IS NEEDED, USE BACK

If well telescopes please
sketch and show depths.

GROUND LEVEL

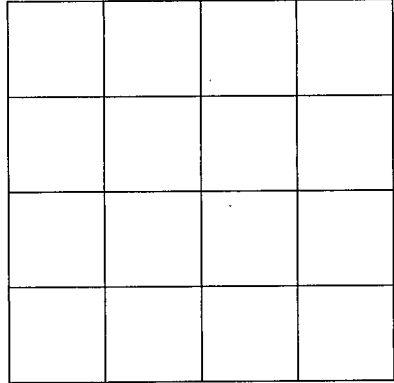

SECTION _____

Please indicate well location X.

ADDITIONAL INFORMATION

If more than one screen,
show location of each on sketch.