

WARREN

WATER WELL DRILLERS LOG

CODED

K1

Date: 10-24-19 61
10-24-61

Driller: *Petrick*
(Name)

County: *Copiah*

- (1) Owner of Land: *R. K. Foley*
(Name)
Wichburg miss
(Address)
- (2) Location: $\frac{1}{4}$ $\frac{1}{4}$, Sec. *1 T6 R9*
5 miles *N 1/2*, of *Cambden*
(distance) (direction) (Nearest Town)
- (3) Topography: *Hilly*
(Hilly) (Flat) (Level)
- (4) Purpose of Well: *Home*
(Domestic Irrigation
Municipal, Industrial, Other)

Description & Color of Materials
Sand, Clay, Red Clay, Shell, etc.

Thick-
ness
Feet

Depth
Feet


0-60 clay
60-141 soft sand

Information upon completion of well:

- (1) Diameter *2* inches.
- (2) Total Depth *141* feet.
- (3) Water Level *101* feet below top of ground.
- (4) Cased to *141*, Size *2*.
- (5) Screen: Size *10 1/2*, Length *5*.
- (6) Were any formations sealed against pollution?
_____ yes, no.

CODED

If YES depth of formation _____
Why _____
Drillers Remarks: _____

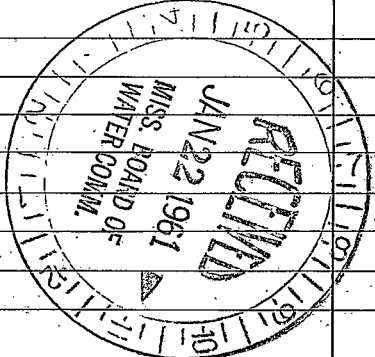

(Use Back Side)

Well No.

