

Warren Co.  
K19  
5-69

MISSISSIPPI  
BOARD OF WATER COMMISSIONERS  
416 North State Street  
Jackson, Mississippi 39201

CODED

CODED

WATER WELL DRILLERS LOG

5-20 1969 EBFORÉ Warren  
date well completed firm name county well located


LANDOWNER: PAT South Hall Vicksburg, Miss (mailing address)	description of formations encountered	from	to
	Brown CL	0	34
	Sand & gravel	54	140
WELL LOCATION: sec. 1 T. 6 <sup>N</sup> R. 4 <sup>E</sup> 6 miles NE of Vicksburg (distance) (direction) (nearest town)			
WELL PURPOSE: Home (home, irrigation, municipal, industrial)			
WELL COMPLETION DATA: (1) diameter (inches) 6 1/2" (2) total depth (feet) 140 (3) static water level (feet) 85 below above top of ground. (4) casing Plastic, 120, (material) (depth) (size) if telescope see back. (5) screen 20, 120 (length) (depth to top) .10 Plastic (size) (material) (6) pump 15 (HP) (yield gpm) Elec (type power) (7) electric log No (yes or no) None (organization running log) (8) how well bottom plugged B.W.U.			
DRILLERS REMARKS:			

APR 24 1969

MISS. Bd. of  
WATER COMMISSIONERS

If well telescopes please sketch and show depths.

GROUND LEVEL

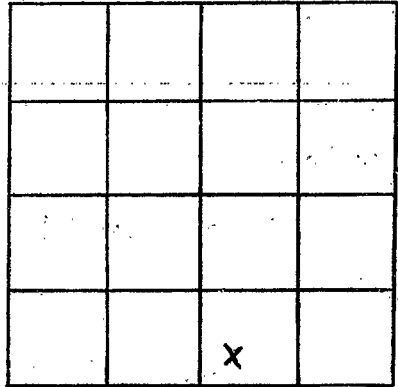

SECTION   /  

Please indicate well location X.

ADDITIONAL INFORMATION

If more than one screen, show locations of each on sketch.