

WARREN
K 20

MISSISSIPPI
BOARD OF WATER COMMISSIONERS
416 North State Street
Jackson, Mississippi 39201

CODED

WATER WELL DRILLERS LOG

date well completed 19 firm name J. H. Barnes county well located Warren

LANDOWNER: Robert Smith
oak Ridge Road
Nicksburg Miss
(mailing address)

| description of formations encountered | from | to |
|---------------------------------------|------------|------------|
| | | |
| <u>top soil</u> | <u>60</u> | <u>100</u> |
| <u>sand & gravel</u> | <u>100</u> | <u>190</u> |
| <u>blue clay</u> | <u>190</u> | <u>315</u> |
| <u>Nicksburg line</u> | <u>315</u> | <u>370</u> |
| <u>Rock</u> | | |
| <u>gray shell</u> | <u>370</u> | <u>390</u> |
| <u>sand</u> | <u>390</u> | <u>450</u> |
| | | <u>450</u> |

WELL LOCATION:
sec. 22 T. 6 N R. 4 E
6 miles North of Nicksburg
(distance) (direction) (nearest town)

WELL PURPOSE:
(home, irrigation, municipal, industrial)

WELL COMPLETION DATA:

- (1) diameter (inches) 2"
- (2) total depth (feet) 450
- (3) static water level (feet) 905 below top of ground.
- (4) casing 2" Galv. 430
(material) (depth)
 if telescope see back.
(size)
- (5) screen 20 feet 430
(length) (depth to top)
80%
(size) (material)
- (6) pump 2 H.P. 2 1/2 GPM
(HP) (yield gpm)
Electric
(type power)
- (7) electric log no.
(yes or no)
 (organization running log)
- (8) how well bottom plugged Back wash
value

CODED


SEP 28 1970

MISS. BD. OF
WATER COMM.

DRILLERS' REMARKS:

If well telescopes please sketch and show depths.

GROUND LEVEL

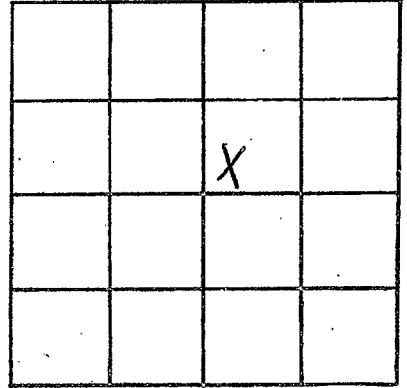

SECTION 23

Please indicate well location X.

ADDITIONAL INFORMATION

Mr. Smith is
the best person
that want
something for
nothing

Hope to see
you soon
John

If more than one screen,
show locations of each on sketch.