

E LOG # 96

WARREN

K22

3-31-71

MISSISSIPPI BOARD OF WATER COMMISSIONERS  
416 North State Street  
Jackson, Mississippi 39201

**CODED**

WATER WELL DRILLERS LOG

3/31/19 date well completed

Wackheim water well ser

Warren county well located

LANDOWNER:

Miss. Highway Dept.

(mailing address)

WELL LOCATION:

sec 25 T 16 N R 4 E  
6 miles E of Weckhuc  
(distance) (direction) (nearest town)

WELL PURPOSE:

(home, irrigation, municipal, industrial)

WELL COMPLETION DATA:

- (1) diameter (inches) 4 in.
- (2) total depth (feet) 275
- (3) static water level (feet) 114 <sup>yellow</sup> above top of ground.
- (4) casing Galv 231  
(material) (depth)
- 4 in (size) if telescope see back.
- (5) screen 10 ft 244  
(length) (depth to top)
- 2 in. Johnson (size) (material)
- (6) pump 3/4 10 gal  
(HP) (yield/gpm)
- Miss. Power (type power)
- (7) electric log yes  
(yes or no)
- O.S. S.S. (organization running log)

description of formations encountered

from

to

brown dirt	0	48
gray shaly sand	48	80
blue clay	80	120
gray sand	120	200
sandy shell	200	244
gray sand	244	260
clay	260	268
gray sand	268	284
clay	284	304
chopped sand and shell	304	375

**CODED**

JUL 13 1971


DRILLERS REMARKS:

MISS. BD. OF WATER COMM.

(8) how well bottom plugged 2 in. back wash valve.

If well telescopes please  
sketch and show depths.

GROUND LEVEL

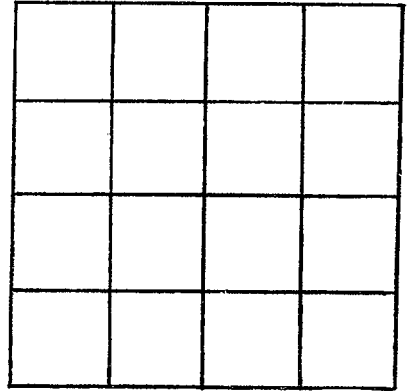

SECTION \_\_\_\_\_

Please indicate well location X.

ADDITIONAL INFORMATION

If more than one screen,  
show locations of each on sketch.