

WARREN

MISSISSIPPI
BOARD OF WATER COMMISSIONERS
416 North State Street
Jackson, Mississippi 39201

7
CODED

K-29
E log # 164
6/15/80
6/15/80
19

WATER WELL DRILLERS LOG

Jack Hume
firm name

Warren
county well located

LANDOWNER:
Miller Condit Company
Hwy 80 pit
(mailing address)

description of formations encountered	from	to
Sand + Shale	0	35
Sandy shale	35	100
Shale	100	125
Sand w/ shale stks.	125	170
lime rock	170	210
clay	320	830
Sand w/ shale stks	830	890
Shale	890	920
Shale w/ sand stks	920	960
Shale	960	1010
Sandy shale	1010	1060
Sand w/ shale stks	1060	1110
Shale	1110	1140
Sand (fine)	1140	1220
Sandy shale	1220	1280
Sand (fine)	1280	1310
Shale w/ sand stks	1310	1440
Sand	210	220
Shale	220	250
Sandy shale	250	275
Shale	275	300
Sand	300	320

WELL LOCATION:
sec. 25 T. 16 N. R. 4 E
S W
miles W of Bovina
(distance) (direction) (nearest town)

WELL PURPOSE: industrial
(home, irrigation, municipal, industrial)

WELL COMPLETION DATA:

(1) diameter (inches) ~~10~~ 6"

(2) total depth (feet) 1440

(3) static water level (feet) 137 below above top of ground.

(4) casing Steel 1140 (material) (depth)

(5) screen If telescope see back.
80 1170 (length) (depth to top)
6 S.S. (007) (size) (material)

(6) pump 20 (sub) 200 (HP) (yield gpm)
elec. (type power)

(7) electric log MSGS (yes) yes or no
Mr. Geo. Surrency (organization running log)

(8) how well bottom plugged


DEPT. OF NATURAL RESOURCES
BUREAU OF LAND & WATER RESOURCES

AUG 19 1980
RECEIVED

DRILLERS REMARKS:

If well telescopes please sketch and show depths.

GROUND LEVEL

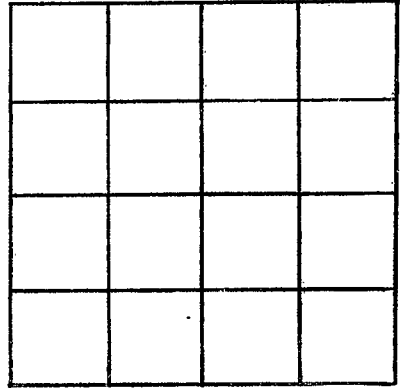

SECTION _____

Please indicate well location X.

ADDITIONAL INFORMATION

If more than one screen, show locations of each on sketch.