

# WARREN WATER WELL DRILLERS LOG

Date: June 23, 1965 <sup>K 2002</sup>, Driller: Crest & Cresswell County Warren  
6-23-65 (Name)

(1) Owner of Land: Hilldale Water Dist. no 1  
 (Name)  
Vicksburg, Miss.  
 (Address)

(2) Location: 1/4, 1/4, Sec. 29 T16R4E  
         miles          of           
 (distance) (direction) (Nearest Town)

(3) Topography:           
 (Hilly) (Flat) (Level)

(4) Purpose of Well: Test  
 (Domestic Irrigation  
 Municipal, Industrial, Other)

Description & Color of Materials Sand, Clay, Red Clay, Shell, etc.	Thick- ness Feet	Depth Feet
<u>Clay</u>	<u>40</u>	<u>40</u>
<u>Shale, Gray</u>	<u>180</u>	<u>220</u>
<u>Sand - Rock &amp; Shale</u>	<u>60</u>	<u>280</u>
<u>Gray Shale</u>	<u>100</u>	<u>380</u>
<u>Sand</u>	<u>30</u>	<u>430</u>
<u>Blue Clay</u>	<u>28</u>	<u>458</u>

**Information upon completion of well:**

(1) Diameter 3 7/8 inches.

(2) Total Depth 458 feet.

(3) Water Level No Test feet below top of ground.

(4) Cased to         , Size         


(5) Screen: Size         , Length         

(6) Were any formations sealed against pollution?  
         yes,          no.

If YES depth of formation         

Why         

Drillers Remarks:         

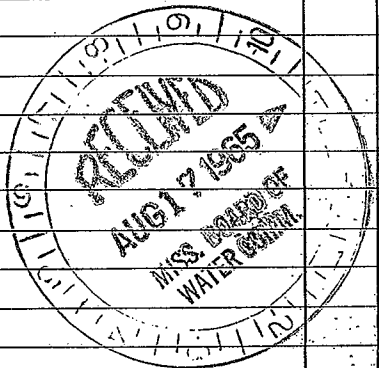

(Use Back Side)

Well No.

