

WARREN

1-12  
8-10-65

Should be  
17 from Bill Oakley

MISSISSIPPI  
BOARD OF WATER COMMISSIONERS  
416 North State Street  
Jackson, Mississippi 39201

Copy  
GIVEN

CODED

WATER WELL DRILLERS LOG

8/10 1965 Forest Drilling Warren  
date well completed firm name county well located

LANDOWNER: Borris  
Water Club  
Vicksburg, Miss.  
(mailing address)

description of formations encountered	from	to
Brown silt	0	35
Chalky clay	35	50
yellow sand (silt)	50	61
fine yellow sand	61	71
yellow sand + gravel	71	81
hard + stls chalk	81	92
C. sand	92	102
Chalky Clay	102	117
fine sand	117	143
fine sand (yellow)	143	153
fine sand	153	163
Med sand	163	185
Blue clay	185	204

WELL LOCATION: BOVINA  
sec 26 T 6 N R 5 E  
6 miles E of Vicksburg  
(distance) (direction) (nearest town)

WELL PURPOSE: Domestic  
(home, irrigation, municipal, industrial)

WELL COMPLETION DATA:

- (1) diameter (inches) 8"
- (2) total depth (feet) 182'
- (3) static water level (feet) 123' below above top of ground.
- (4) casing Steel, 158'  
(material) (depth)  
8"  
(size) if telescope see back.
- (5) screen 25', 157'  
(length) (depth to top)  
6", stainless steel  
(size) (material)
- (6) pump 10 80  
(HP) (yield gpm)  
Elect  
(type power)
- (7) electric log no  
(yes or no)

(organization running log)

(8) how well bottom plugged 6" x 2"  
Backbit + Valve

DRILLERS REMARKS:

CULKIN WATER DISTRICT  
ABANDONED / PLUGGED  
2/17/65  
LANNING CENTRAL


APR 17 1969

MISS. RD. OR  
WATER COMM.

(X)

If well telescopes please sketch and show depths.

GROUND LEVEL

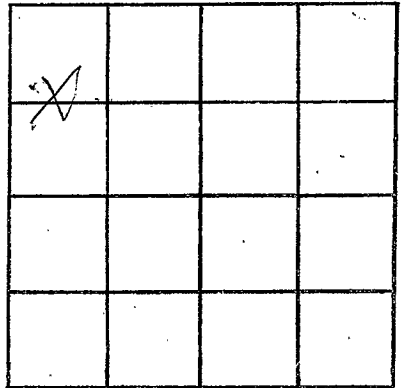

SECTION *26*

Please indicate well location X.

ADDITIONAL INFORMATION

If more than one screen, show locations of each on sketch.