

COPY

ELOG #91

WARREN

LB

6-4-69

MISSISSIPPI
BOARD OF WATER COMMISSIONERS
416 North State Street
Jackson, Mississippi 39201

WATER WELL DRILLERS LOG

6-4

1969 - McCowell

date well completed

firm name

Warren

county well located

LANDOWNER: Mr. Bovina

description of formations encountered

from

to

Bovina Miss.
(mailing address)

Tan Soil & Red Clay	0	60
Dry Sand / Red	60	94
Clay - Red & White	94	143
Sand & Gravel (Dry)	143	210
Lignite	210	240
Rock & Clay streaks	240	300
Clay	300	325
Sandy Clay	325	380
Shale	380	426
Sandy clay (Fine Sand)	426	468
Sandy clay	468	528
Sand	528	1060
Shale	1060	1065

WELL LOCATION:

sec. 30 T 16 N R 5 E

2 miles S 12' of Bovina
(distance) (direction) (nearest town)

WELL PURPOSE: home (farm)
(home, irrigation, municipal, industrial)

WELL COMPLETION DATA:

- (1) diameter (inches) 4 X 2
(2) total depth (feet) 1037'
(3) static water level (feet) 192 below
top of ground.
(4) casing Steel, 1037',
(material) (depth)

4 X 2" if telescope see back.
(size)

(5) screen 20', 1037'
(length) (depth to top)

2", Stainless Steel,
(size) (material)

(6) pump 1 1/2, 20
(HP) (yield gpm)
610cf,
(type power)

(7) electric log Yes
(yes or no)
M. G. S.
(organization running log)

(8) how well bottom plugged
Bad Wash Valve.

DRILLERS REMARKS:

Red Water.

COPIED

If well telescopes please
sketch and show depths.

GROUND LEVEL

286' 4"


4x2 wedge,

2"

30' screen

1037'

If more than one screen,
show locations of each on sketch.

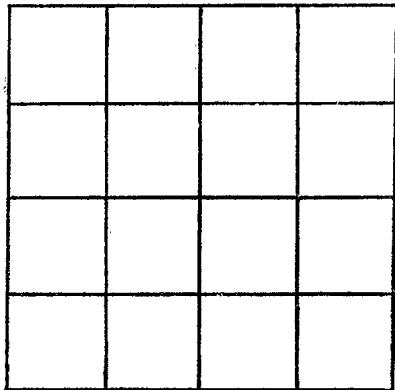

SECTION 30

Please indicate well location X.

ADDITIONAL INFORMATION

(This section contains 15 blank lines for additional information.)