

Waver
L9
1-5-62

WATER WELL DRILLERS LOG

OK 7/29/69

CODED

Date: 1-5, 19 62 Driller: Robert County: Waltham
(Name)

(1) Owner of Land: Ray Price
(Name)
Verobling Miss.
(Address)

(2) Location: 1/4, 1/4, Sec. 0604, T R
3 miles (distance) North, of Clarendon (direction) (Nearest Town)

(3) Topography: Flat
(Hilly) (Flat) (Level)

(4) Purpose of Well: Home
(Domestic Irrigation
Municipal, Industrial, Other)

Description & Color of Materials Sand, Clay, Red Clay, Shell, etc.	Thick- ness Feet	Depth Feet
<u>0-47 clay</u>		
<u>47-70 clay</u>		
<u>70-148 clay</u>		
<u>148-173 fine sand</u>		

Information upon completion of well:

(1) Diameter 2 inches.

(2) Total Depth 173 feet.

(3) Water Level 21 feet below top of ground.

(4) Cased to 173, Size 2"

(5) Screen: Size 2", Length 5'


(6) Were any formations sealed against pollution?
_____ yes, no no.

Drilled 280'
hole about 200'
south of well
but no sand
formation a fall

If YES depth of formation _____

Why _____

Drillers Remarks: Drilled and
to 200 feet
no

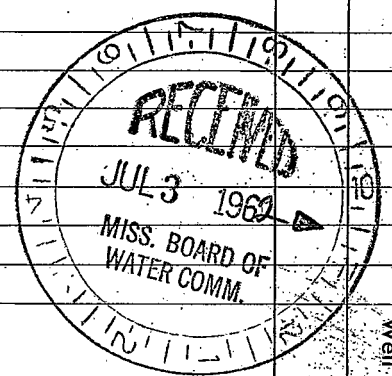

(Use Back Side)

Well No.

