

WARREN  
211  
11-14-69

MISSISSIPPI  
BOARD OF WATER COMMISSIONERS  
416 North State Street  
Jackson, Mississippi 39201

WATER WELL DRILLERS LOG

CODED

Nov 14 1969 McCConnell Drilling Co. Warren  
date well completed firm name county well located

LANDOWNER:  
King Merritt  
Bovina Miss.  
(mailing address)

WELL LOCATION:  
sec. 21 T. 46 N. R. 5 E.  
1 miles East of Bovina  
(distance) (direction) (nearest town)

WELL PURPOSE: Farm.  
(home, irrigation, municipal, industrial)

WELL COMPLETION DATA:  
(1) diameter (inches) 4 1/8  
(2) total depth (feet) 222'  
(3) static water level (feet) 35' below above top of ground.  
(4) casing Steel, 212'  
(material) (depth)  
4" If telescope see back.  
(size)  
(5) screen 10', 212'  
(length) (depth to top)  
3", Stainless Steel  
(size) (material)  
(6) pump 3/4 8  
(HP) (yield gpm)  
Elec.  
(type power)  
(7) electric log Yes  
(yes or no)  
U.S.G.S.  
(organization running log)  
(8) how well bottom plugged  
Back wash Valve

description of formations encountered	from	to
clay	0	70
Sand Gravel	70	92
Blue Clay	92	114
lime streaked clay	114	170
Blue Clay Shale	170	210
Sand & Shale streaks	210	280
Blue Clay	280	314


NOV 18 1969

MISS. Bd. OF WATER COMM.

DRILLERS REMARKS:  
Very fine Sand  
Good Yield

If well telescopes please sketch and show depths.

GROUND LEVEL

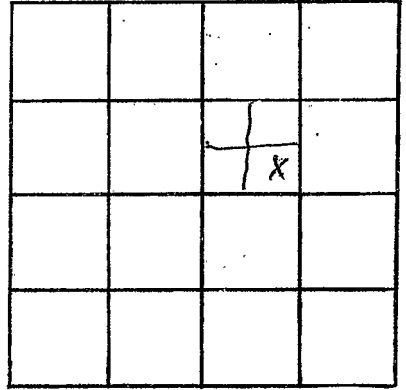

SECTION 21

Please indicate well location X.

ADDITIONAL INFORMATION

If more than one screen, show locations of each on sketch.