

WARREN
L12
11-12-73
E log # 122

MISSISSIPPI
 BOARD OF WATER COMMISSIONERS
 416 North State Street
 Jackson, Mississippi 39201

CODEC

WATER WELL DRILLERS LOG

date well completed 11/12 19 73 firm name JACK GOMM WARREN county well located _____

LANDOWNER: HARRY STUART
 (mailing address) _____


description of formations encountered	from	to
TOP SOIL	0	1
CLAY	1	10
GRAVEL SAND	10	50
ROCK SAND	50	100
	100	160

WELL LOCATION:
 sec 13 T 6 N R 4 E
 (distance) miles (direction) of (nearest town)

WELL PURPOSE:
 (home, irrigation, municipal, industrial)

- WELL COMPLETION DATA:
- (1) diameter (inches) 4"
 - (2) total depth (feet) 160
 - (3) static water level (feet) 110 below above top of ground.
 - (4) casing 1 1/2 (material), 148 (depth)
 - 44 (size) if telescope see back.
 - (5) screen 2 1/2 (length), 148 (depth to top)
 - 2 1/2 (size), SS (material)
 - (6) pump 1 (HP), 10 (yield gpm)
 - MPL (type power)
 - (7) electric log YES (yes or no)
 - USA (organization running log)
 - (8) how well bottom plugged 13.w.v.

CODEC

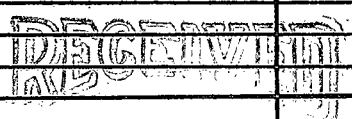

DRILLERS REMARKS:

JAN 1 1974

COMM.

If well telescopes please sketch and show depths.

GROUND LEVEL



SECTION _____

Please indicate well location X.

ADDITIONAL INFORMATION

Lined area for additional information.



3/12
-150
-65

If more than one screen, show locations of each on sketch.