

WARREN
L13
3-17-71

MISSISSIPPI
BOARD OF WATER COMMISSIONERS
416 North State Street
Jackson, Mississippi 39201

CODED

WATER WELL DRILLERS LOG

3/17 1971 Jack Seim Water Warren
date well completed firm name county well located
No. 22 Ser.

LANDOWNER: Bovina
Water Club,
Bovina, Miss.
(mailing address)

description of formations encountered	from to	
	ft	ft
yellow sand	0	102
shell	102	120
gray sand	120	190
crsdy shell	190	220

WELL LOCATION:
sec 20 T 16 N R 5 E
10 miles E of Vicksburg
(distance) (direction) (nearest town)

WELL PURPOSE:
(home, irrigation, municipal, industrial)

- WELL COMPLETION DATA:
- (1) diameter (inches) 4 in.
 - (2) total depth (feet) 220
 - (3) static water level (feet) 124 below top of ground.
 - (4) casing 4 in. 160 ft.
(material) (depth)
 - (size) If telescope see back.
 - (5) screen 4 in. 162 ft.
(length) (depth to top)
 - (size) (material)
4 in. Johnson SS.
 - (6) pump 2 50
(HP) (yield gpm)
 - R. C. A.
(type power)
 - (7) electric log yes
(yes or no)
 - U.S. G.S.
(organization running log)
 - (8) how well bottom plugged back
was same

CULPIN WATER DRINK
planned 2/17/75
LAWRENCE
CANTON

CODED

JUL 15 1971


MISS. BD. OF
WATER COMM.

DRILLERS REMARKS:

If well telescopes please sketch and show depths.

GROUND LEVEL

*water level 124 ft
pump setting 180 ft
5H. P. Sub.*

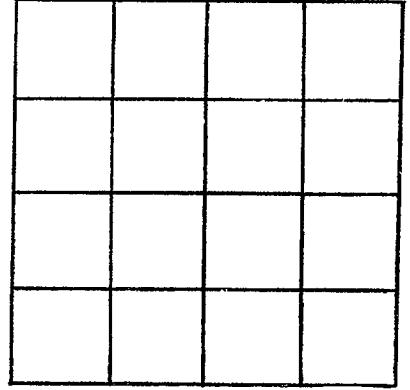

SECTION _____

Please indicate well location X.

ADDITIONAL INFORMATION

If more than one screen,
show locations of each on sketch.